PREPARED FOR: BETTY NORTON
W1007 PELL LAKE DR.
GENOA CITY WI. 53128


PLAT OF SURVEY


OF

LOTS 4089-4093 BLOCK 82 PELL LAKE SUBDIVISION, A SUBDIVISION LOCATED IN SECTION 15, TOWN 1 NORTH, RANGE 18 EAST, TOWN OF BLOOMFIELD, WALWORTH COUNTY, WISCONSIN PATHFINDER SURVEYING INC. N3705 WILLOW BEND LANE LAKE GENEVA WI. 53147

C.L. PELL LAKE DRIVE

(50' WIDE ROAD)

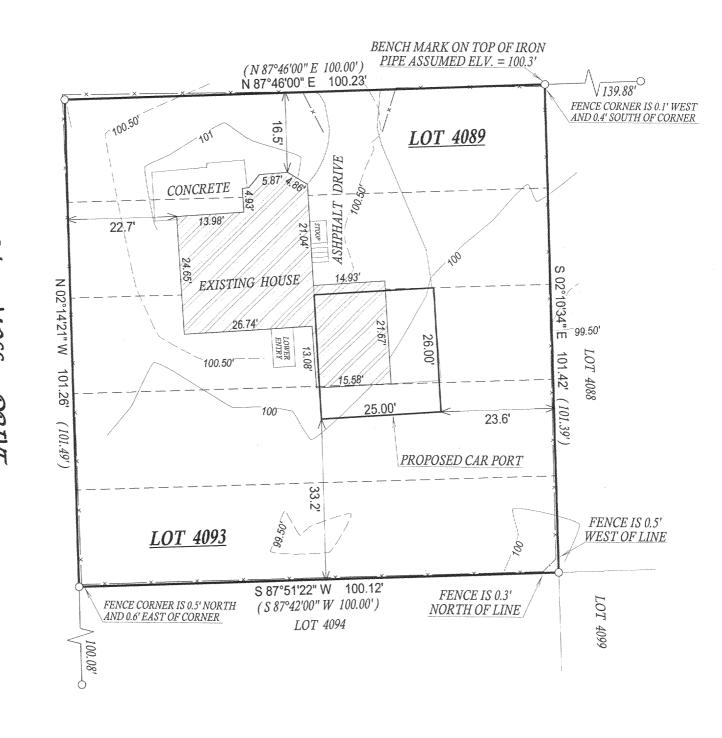

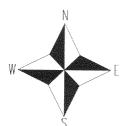

(40' WIDE ROAD,

()= recorded as

 \Box = found iron bar

= found iron pipe

= set iron pipe

= set iron bar

SCALE 1" = 20'

COMPARE LEGAL DESCRIPTION ABOVE AND DRAWING WITH DEED. FOR BUILDING RESTRICTIONS AND EASEMENTS NOT SHOWN, REFER TO DEED, ABSTRACT SOURCES AND LOCAL MUNICIPAL CODES. NOTIFY THE SURVEYOR IMMEDIATELY OF ANY DISCREPANCY.

JOB # 05-349

"I hereby certify that I have surveyed the above described property and that the above map, to the best of my knowledge and belief, is a true representation thereof and shows the size and location of all visible structures, apparent easements and encroachments if any."

TAX ID # MPL00856

easements and encroachmentsif any."

This survey is made for the present owners of the property, and those who purchase, mortgage, or guarentee the title thereto, within one year from the date hereof.



JOHN KROTT S - 2258
Wisconsin Registered Land Surveyor

(original if signed in red) DATED THIS THE 12th DAY OF JULY 2005.

118-2615