


PLAT OF SURVEY

OF

Lots 4865, 4866 and 4767, Block 93 of PELL LAKE SUBDIVISION, being a subdivision of part of Section 15, Township 1 North, Range 18 East of the 4th Principal Meridian, Bloomfield Township, Walworth County, Wisconsin.

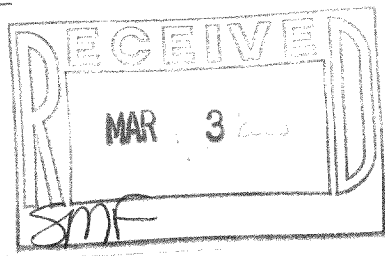

NOTE: GARAGE MEASUREMENTS ARE FACE OF SIDING. GARAGE TIES TO PROPERTY LINES ARE TO FOUNDATION CORNERS



SCALE 1 inch = 30 feet

ORDERED BY R. Krenz

JOB NO. 05174

I hereby certify that I have surveyed the above described property and the above plat is a true representation thereof and shows the size and location of the property, its exterior boundaries, the location and dimensions of all visible structures thereon, boundary fences, apparent easements and roadways and visible encroachments, if any.

This survey is made for the exclusive use of the present owners of the property, and also those who purchase, mortgage, or guarantee the title thereto within one year from the date hereof.

Dated at Bassett, Wisconsin this _____ day of _____ 2005.

Mark A. Bolender
Wisconsin Registered Land Surveyor S - 1784

MPL-1038

118-2698