


# PLAT OF SURVEY OF

Lots 1927 thru 1922, Block 60 of SECTION 2 PELL LAKE, a subdivision of part of Section 22, Township 1 North, Range 18 East of the 4th Principal Meridian, Town of Bloomfield, Walworth County, Wisconsin.

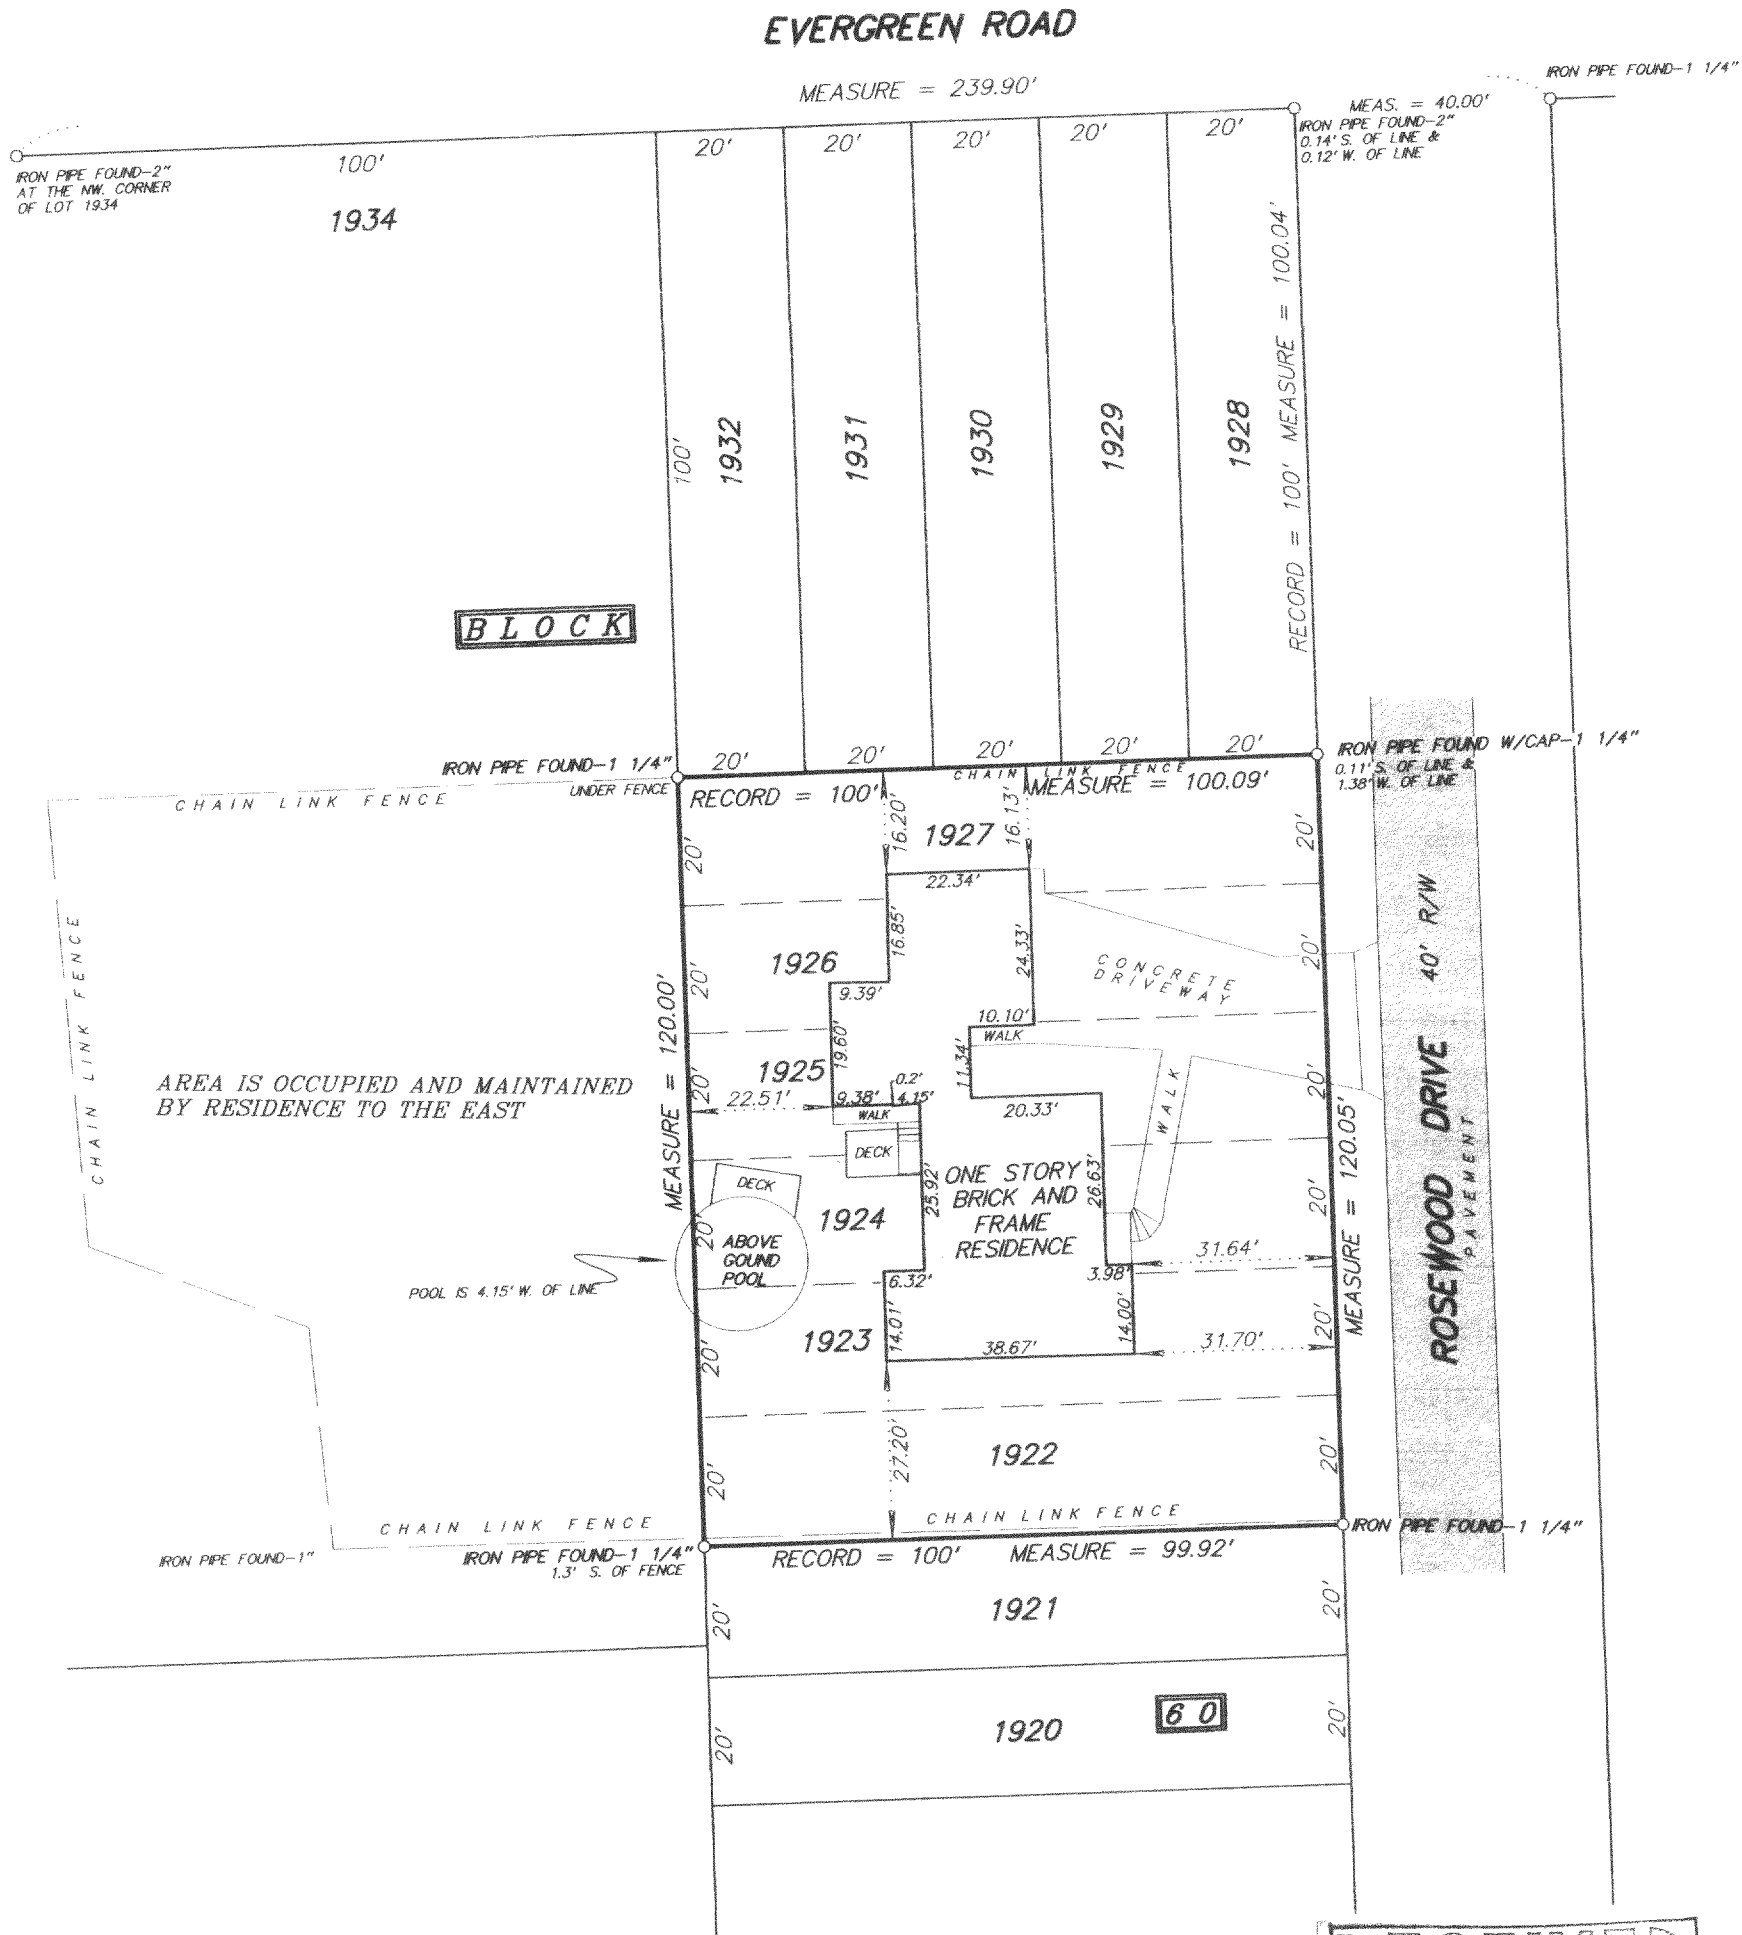


SCALE 1 inch = 30 feet

ORDERED BY D. Hardy / Four Seasons Sunrooms

JOB NO. 05287

MPL-418

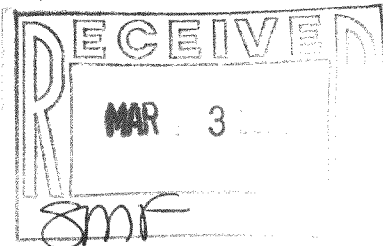

I hereby certify that I have surveyed the above described property and the above plat is a true representation thereof and shows the size and location of the property, its exterior boundaries, the location and dimensions of all visible structures thereon, boundary fences, apparent easements and roadways and visible encroachments, if any.

This survey is made for the exclusive use of the present owners of the property, and also those who purchase, mortgage, or guarantee the title thereto within one year from the date hereof.

Dated at Bassett, Wisconsin this \_\_\_\_\_ day of \_\_\_\_\_ 2005.

Mark A. Bolender  
Wisconsin Registered Land Surveyor S - 1784

118-2700