
PREPARED FOR: SCOTT JOHNSON REMAX LAKE GENEVA 101 BROAD STREET LAKE GENEVA, WI 53147

PLAT OF SURVEY

PATHFINDER SURVEYING, INC. N3705 WILLOW BEND LÂNE LAKE GENEVA, WI 53147 (262) 248-3697

- OF -

LOTS 4059 THRU 4063 IN BLOCK 82 IN PELL LAKE SUBDIVISION, A SUBDIVISION LOCATED IN SECTION 15, TOWN 1 NORTH, RANGE 18 EAST, TOWN OF BLOOMFIELD, WALWORTH COUNTY, WISCONSIN

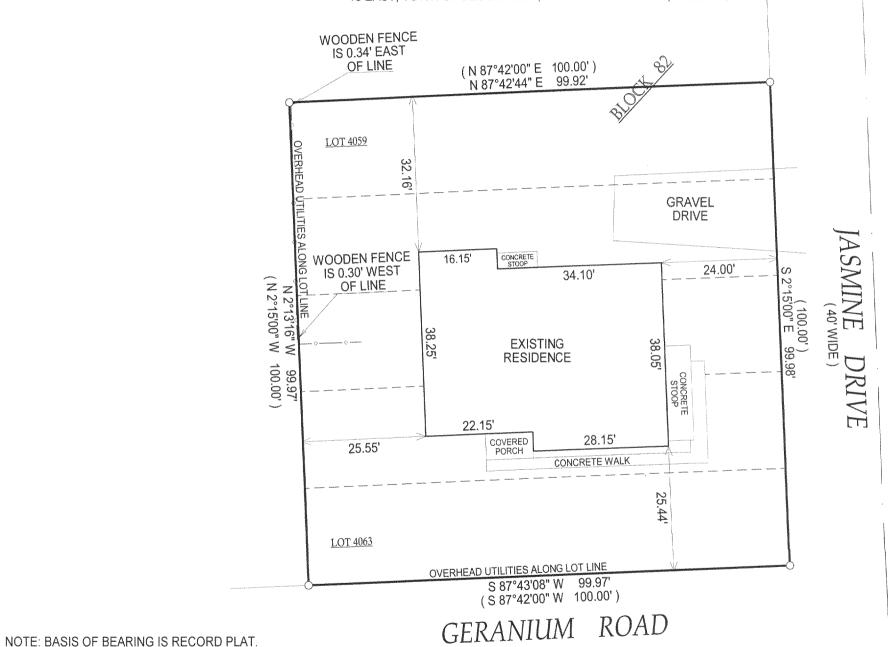

(40' WIDE)


() = RECORDED AS

SCALE: 1" = 20'

COMPARE LEGAL DESCRIPTION ABOVE AND DRAWING WITH DEED. FOR BUILDING RESTRICTIONS AND EASEMENTS NOT SHOWN, REFER TO DEED, ABSTRACT SOURCES AND LOCAL MUNICIPAL CODES. NOTIFY THE SURVEYOR IMMEDIATELY OF ANY DISCREPANCY.

"I hereby certify that I have surveyed the above described property and that the above map, to the best of my knowledge and belief, is a true representation thereof and shows the size and location of all visible structures, apparent easements and encroachments if any."

This survey is made for the present owners of the property, and those who purchase, mortgage, or guarantee the title thereto, within one year from the date hereof.

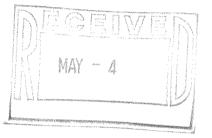



JOHN KROTT S - 2258 Wisconsin Registered Land Surveyor

(original if signed in red)

DATED THIS 21st DAY OF MARCH, 2006.

□ = FOUND IRON BAR

= FOUND IRON PIPE

■ = SET IRON BAR

= SET IRON PIPE

IOB #: 06-101

TAX ID #: MPL 00850