


PREPARED FOR:
 TOM AND JEAN FISCUS
 P.O. BOX 877
 PELL LAKE WI
 53157


PATHFINDER SURVEYING, INC.
 N3705 WILLOWBEND LANE
 LAKE GENEVA, WI, 53147
 262-248-3697

(" THIS LOT LINE ADJUSTMENT BETWEEN ADJOINING LAND OWNERS DOES NOT CREATE ADDITIONAL LOTS AND THE ORIGINAL PARCELS ARE NOT REDUCED BELOW THE MINIMUM SIZE REQUIRED BY WALWORTH COUNTY ZONING ORDINANCES, ")

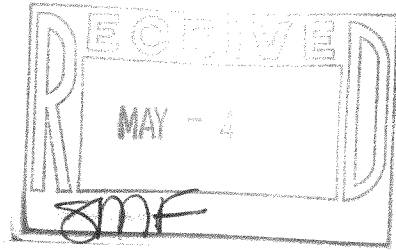

PLAT OF SURVEY

- OF -

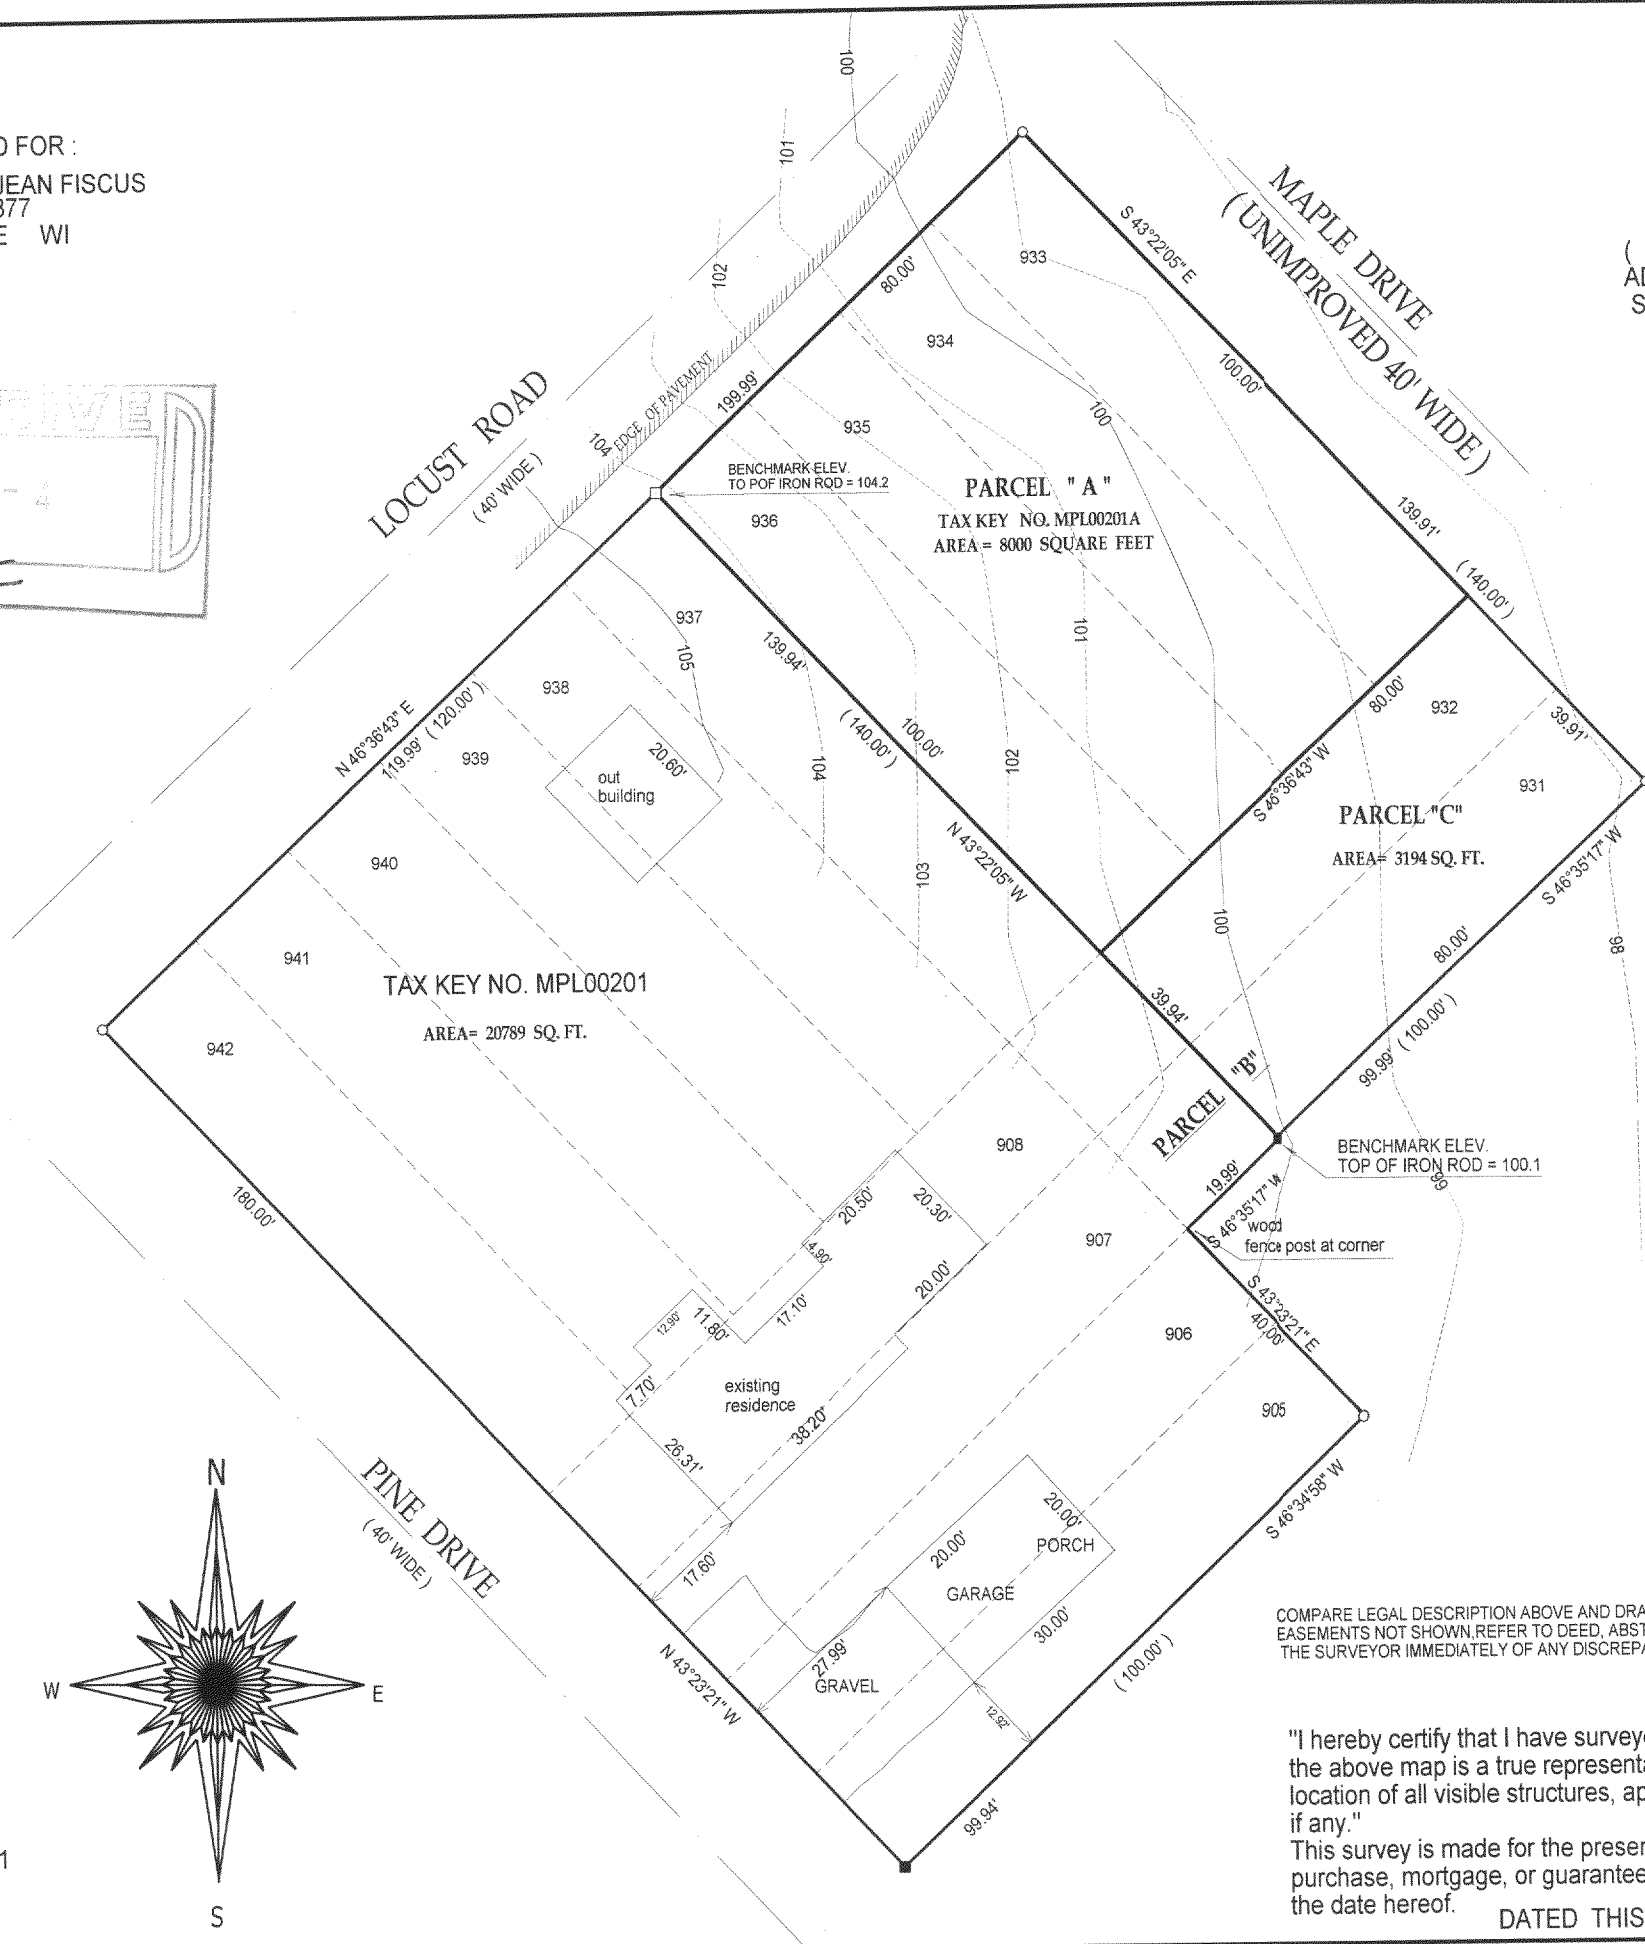

PARCEL "A" LOTS 933-936 BLOCK 19 PELL LAKE SUBDIVISION, A SUBDIVISION LOCATED ,TOWN 1 NORTH, RANGE 18 EAST, TOWN OF BLOOMFIELD, WALWORTH COUNTY, WISCONSIN

PARCEL "B" LOTS 905 THRU 908 ,931,932 and 937 THRU 942 BLOCK 19 PELL LAKE SUBDIVISION, A SUBDIVISION LOCATED IN ,TOWN 1 NORTH, RANGE 18 EAST, TOWN OF BLOOMFIELD, WALWORTH COUNTY, WISCONSIN

PARCEL "C" THE EASTERLY 80 FEET OF LOTS 931 AND 932 BLOCK 19 PELL LAKE SUBDIVISION, LOCATED IN ,TOWN 1 NORTH , RANGE 18 EAST, TOWN OF BLOOMFIELD, WALWORTH COUNTY, WISCONSIN


NOTE: PARCEL "C" IS TO BE TAKEN FROM PARCEL "B" AND ADDED TO PARCEL "A"

- () = recorded as
- = found iron bar
- = found iron pipe
- = set iron pipe
- = set iron bar

SCALE 1" = 30'

JOB # 03-352


TAX ID # mpl 00201

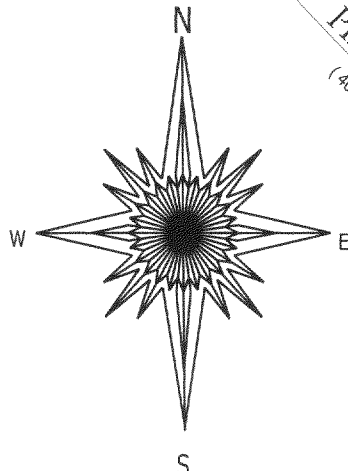

COMPARE LEGAL DESCRIPTION ABOVE AND DRAWING WITH DEED. FOR BUILDING RESTRICTIONS AND EASEMENTS NOT SHOWN, REFER TO DEED, ABSTRACT SOURCES AND LOCAL MUNICIPAL CODES. NOTIFY THE SURVEYOR IMMEDIATELY OF ANY DISCREPANCY.

"I hereby certify that I have surveyed the above described property and that the above map is a true representation thereof and shows the size and location of all visible structures, apparent easements and encroachments if any."
 This survey is made for the present owners of the property, and those who purchase, mortgage, or guarantee the title thereto, within one year from the date hereof.

DATED THIS 17 TH, DAY OF JUNE 20 03

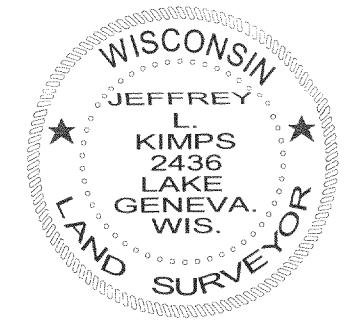

DATE OF LAST REVISION: 2 / 14 / 2006

Jeffrey L. Kimps
 JEFFREY L. KIMPS S - 2436
 Wisconsin Registered Land Surveyor
 (original if signed in red)

MPL-201

118-2714