
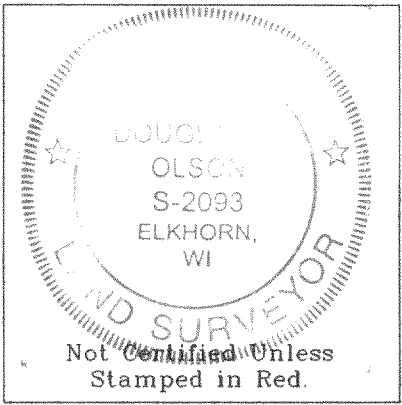


Plat of Survey

of
Lot 12 of Tuscany of Lake Geneva,
a subdivision located in the Northwest 1/4 of Section 3,
Town 1 North, Range 18 East, Town of Bloomfield,
Walworth County, Wisconsin.

Surveyed for: **Keefe Real Estate, Inc.**
980A North Wisconsin Street
Elkhorn, Wisconsin 53121

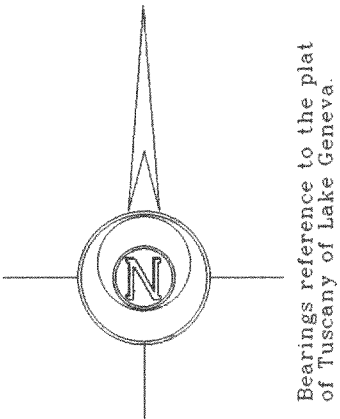


- Notes: 1) This survey plat is not certified unless signed and sealed in red ink.
2) This survey is subject to Wisconsin lien laws. This Plat of Survey is the notice of intent to file lien. Lien waiver required.

Copyright © 2006 by Jensen & Olson Land Surveying, LLC.
All rights reserved. No part of this survey plat may be reproduced or transmitted in any form by any means - graphic, electronic, or mechanical, including photocopying, tracing, or information storage and retrieval systems - without permission in writing from Douglas G. Olson, Jensen & Olson Land Surveying, LLC.

I hereby certify that I have surveyed the above described property and the map hereon is correct to the best of my professional knowledge and belief and shows the size and location of the property, its exterior boundaries, the location and dimensions of all visible structures thereon, boundary fences, apparent easements and roadways and visible encroachments, if any.
This survey is made for the exclusive use of the present owners of property, and also those who purchase, mortgage or guarantee title thereto, within one year from the date hereof.

Douglas G. Olson
Wisconsin Registered Land Surveyor - 2093

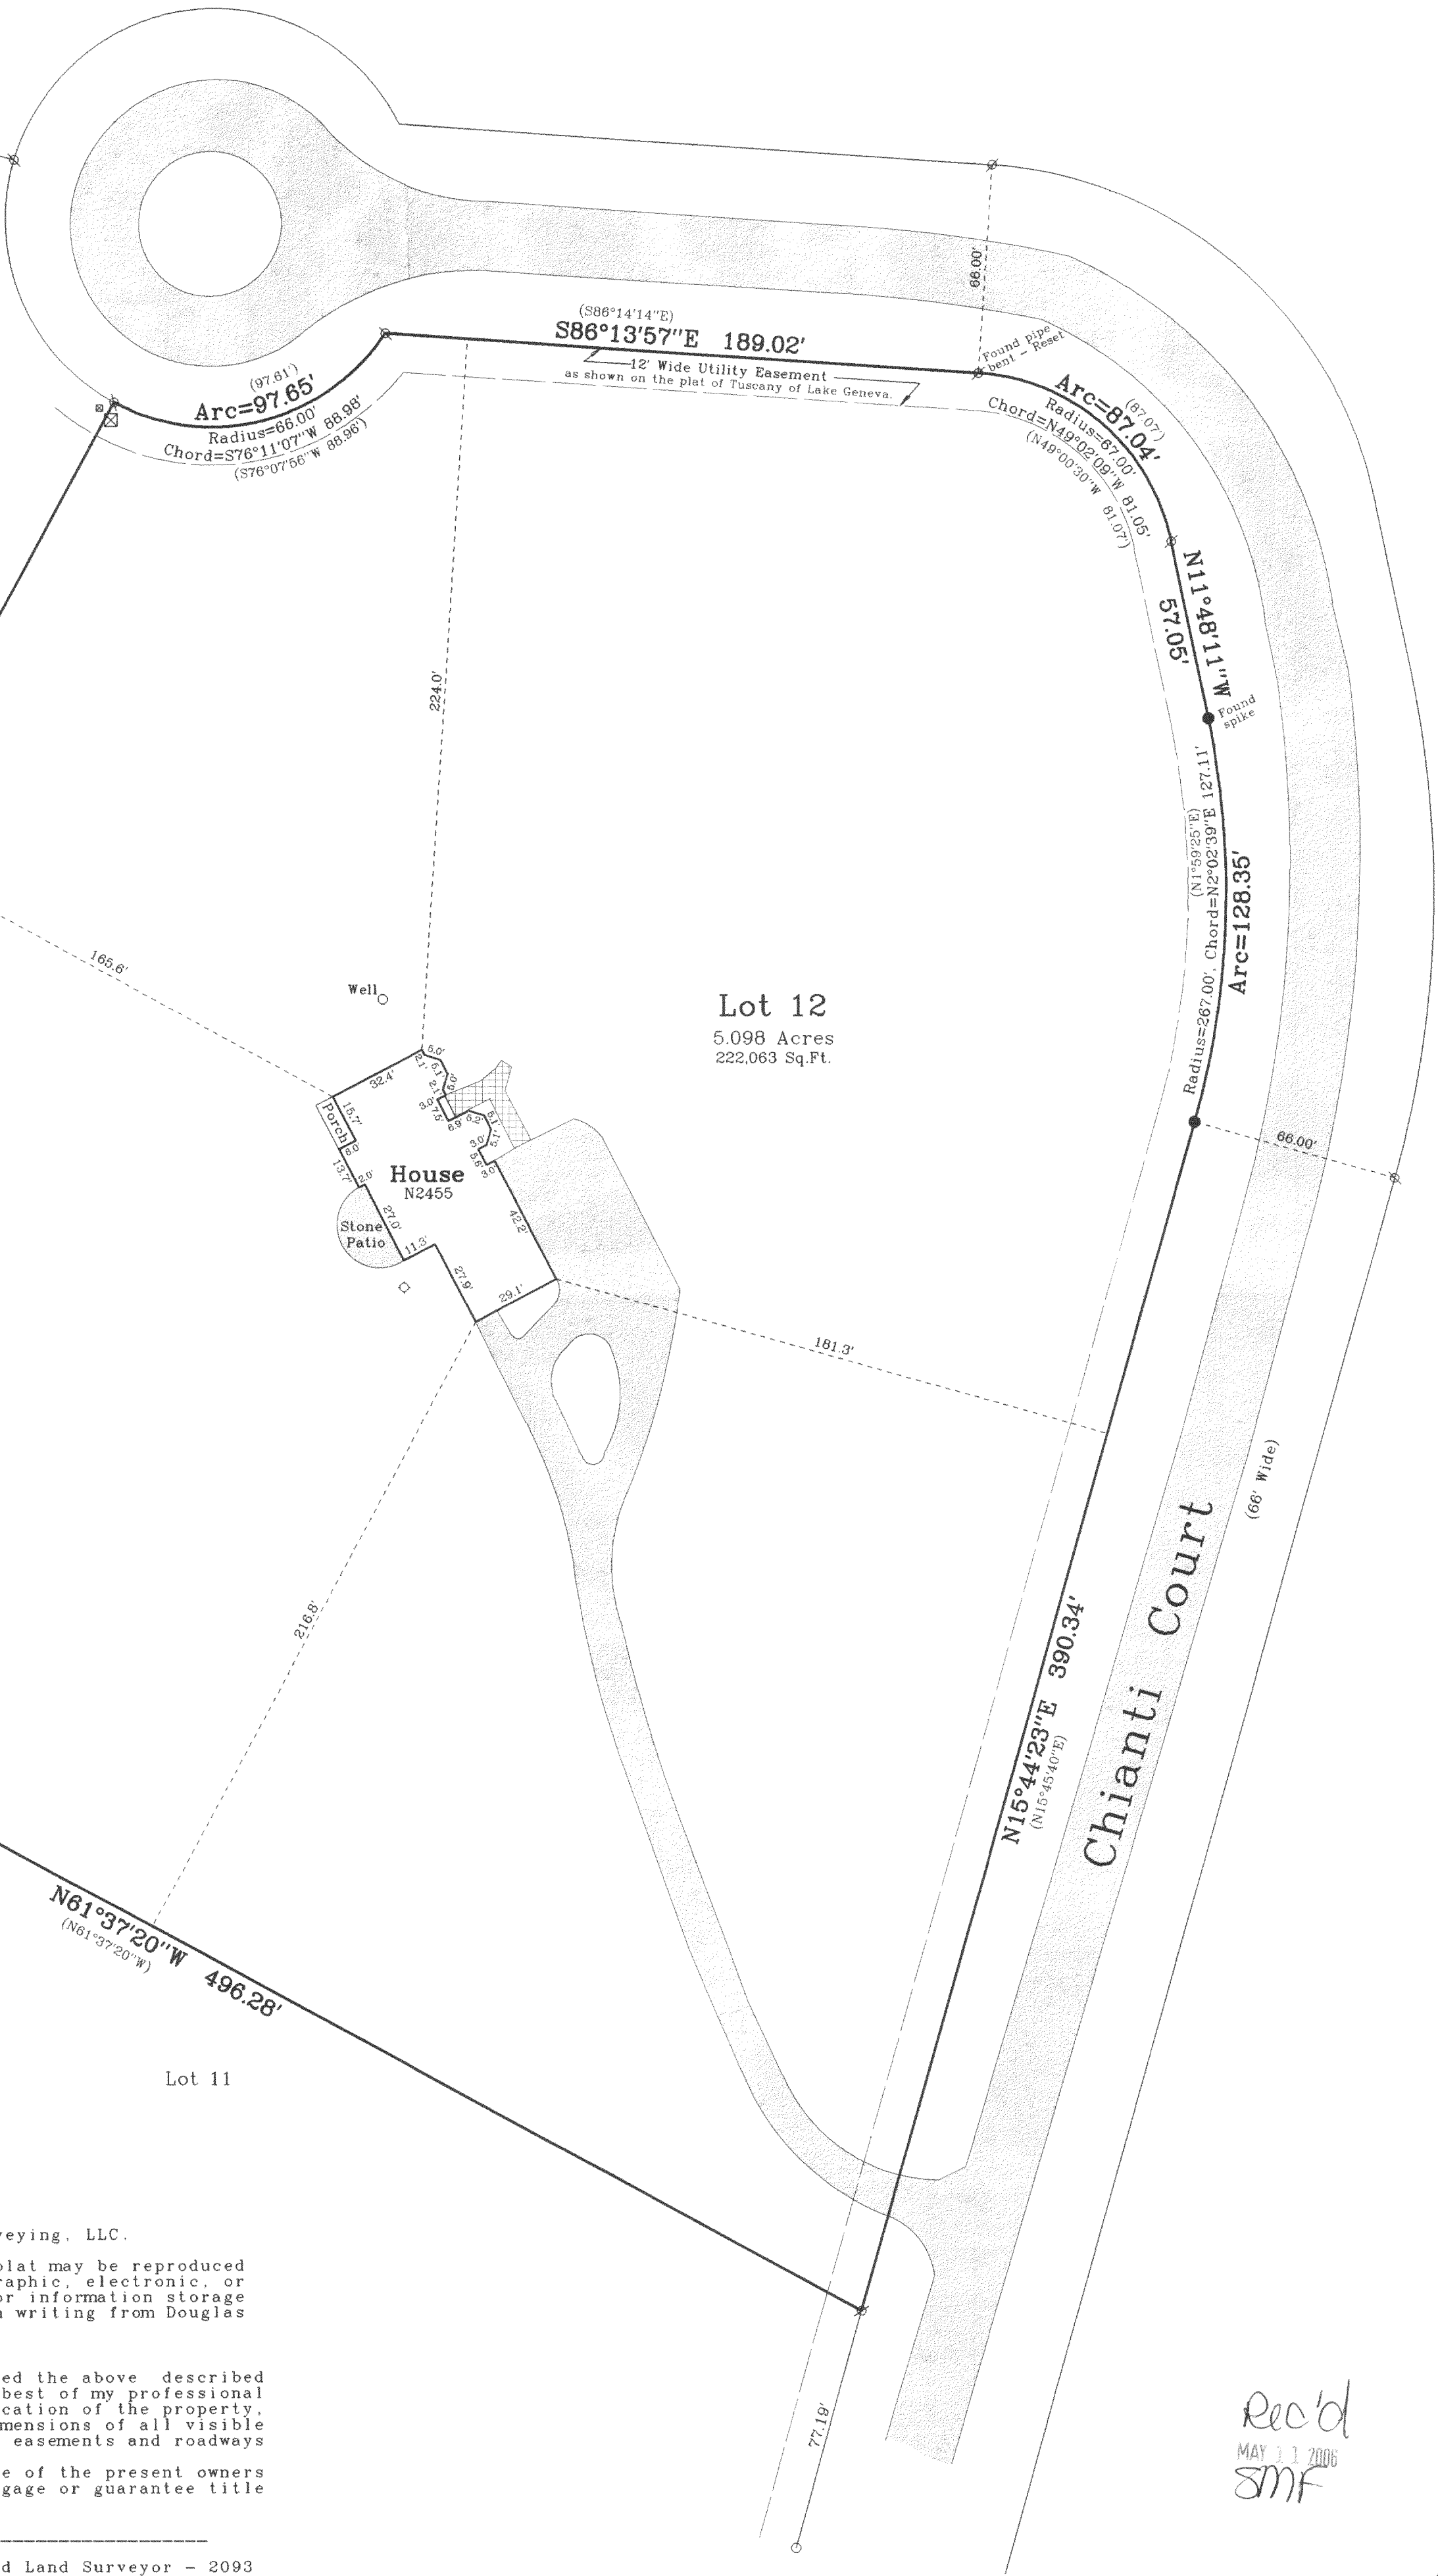

Rec'd
MAY 31 2006
SMF

MTU-12

118-2723