Plat of Survey

Lot 1 of Heartland Subdivision,


located in the Northeast 1/4 of Section 16, Town 1 North, Range 18 East, Town of Bloomfield, Walworth County, Wisconsin.


Surveyed for:

Dan Wise

466 Dutton Street * Apt. 5 Burlington, Wisconsin. 53105



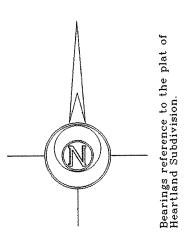

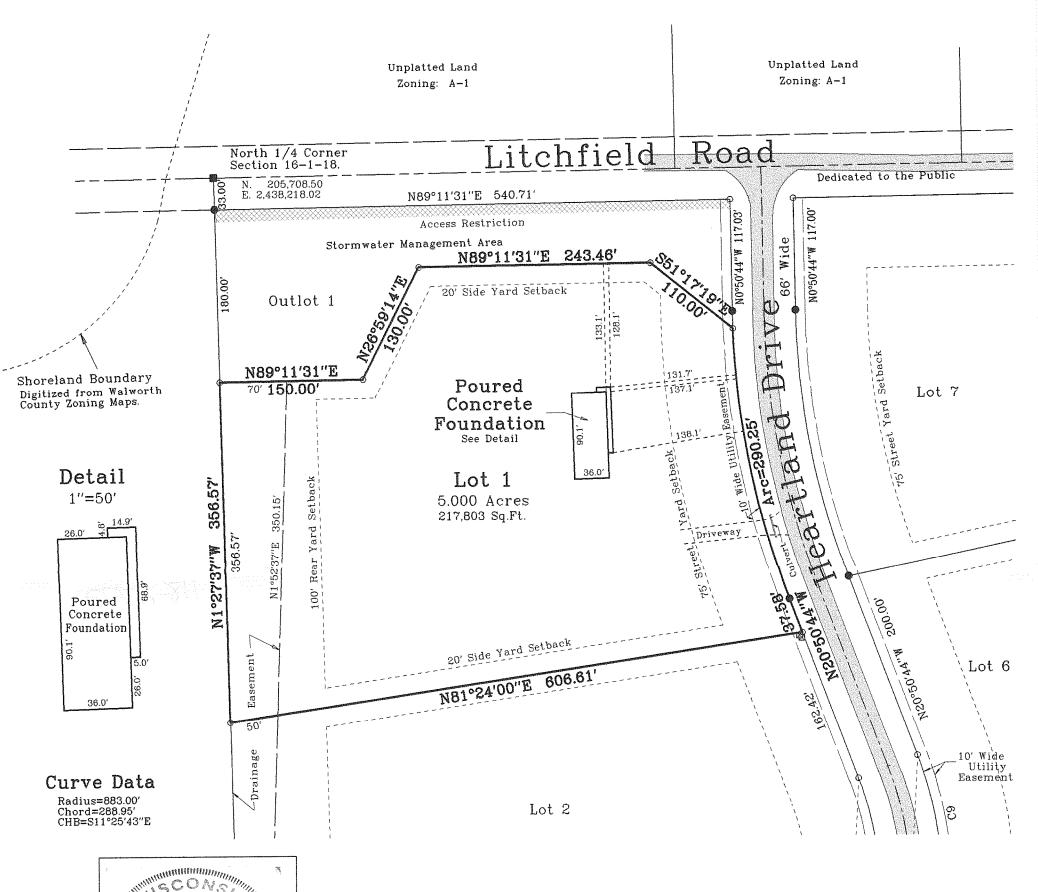

MISCONS DOUGLAS G OLSON S-2093 ELKHORN, WI Was certified Upic. certified uniess

Copyright c 2006 by Jensen & Olson Land Surveying, LLC.

All rights reserved. No part of this survey plat may be reproduced or transmitted in any form by any means - graphic, electronic, or mechanical, including photocopying, tracing, or information storage and retrieval systems - without permission in writing from Douglas G. Olson, Jensen & Olson Land Surveying, LLC.

I hereby certify that I have surveyed the above described property and the map hereon is correct to the best of my professional knowledge and belief and shows the size and location of the property, its exterior boundaries, the location and dimensions of all visible structures thereon, boundary feaces, apparent easements and roadways and visible encroachments, if any.

This survey is made for the exclusive use of the present owners of property, and also those who purchase, mortgage or guarantee title thereto, within one year from the date hereof.

Douglas G. Olson Wisconsim Registered Land Surveyor - 2093

Notes:

- This survey plat is not certified unless signed and sealed in red ink.
- This survey is subject to Wisconsin lien laws. This Plat of Survey is the notice of intent to file lien. Lien waiver required.

Legend

Found Iron Rod, 1-3/16" dia. Found Iron Rod, 3/4" dia. Found Iron Pipe

() Recorded Information Utility Box or Pedestal

🕱 Gas Sign

Asphalt Surface

MHE-1

Jensen & Olson Land Surveying, LLC

45 South Wisconsin Street P.O. Box 322

Elkhorn, Wisconsin. 53121 Telephone: (262) 723-3434 Facsimile: (262) 723-8044

Scale: 1'' = 100'200 50 100

Job Reference Number: 118-2712 2006.028

Survey date: October 29, 2004. Revisions: No. 1 - Proposed Hse No. 2 - Foundation

Sheet 1 of 1 Sheets.