

PLAT OF SURVEY -OF-

LOTS 1007, 1008, 1009, 1010, AND 1011 IN SECTION 1 OF PELL LAKE, A SUBDIVISION IN WALWORTH COUNTY, WISCONSIN.

ALSO:

THAT PART OF THE NORTHEAST QUARTER OF THE NORTHEAST QUARTER OF SECTION 21, TOWNSHIP 1 NORTH, RANGE 18 EAST OF THE FOURTH PRINCIPAL MERIDIAN, BOUNDED AS FOLLOWS: ON THE NORTHWEST BY THE SOUTHWESTERLY EXTENSION OF THE NORTHWESTERLY LINE OF LOT 1011 IN BLOCK 23 IN PELL LAKE ON THE SOUTHEAST BY THE SOUTHWESTERLY EXTENSION OF THE SOUTHEASTERLY LINE OF LOT 1007 IN SAID BLOCK 23 AND ON THE NORTHEAST AND SOUTHWEST BY LINES PARALLEL WITH AND DISTANT 50 FEET NORTHEASTERLY AND 100 FEET SOUTHWESTERLY, MEASURED AT RIGHT ANGLES FROM THE CENTER LINE OF THE MAIN TRACK OF THE STATE LINE AND UNION RAIL ROAD COMPANY (NOW CHICAGO AND NORTH WESTERN TRANSPORTATION COMPANY) AS SAID MAIN TRACK CENTER LINE WAS ORIGINALLY LOCATED AND ESTABLISHED OVER AND ACROSS SAID SECTION 21. SAID LAND BEING IN THE TOWN OF BLOOMFIELD, COUNTY OF WALWORTH AND STATE OF WISCONSIN.

SURVEY FOR: FOCUS REALTY
SURVEY ADDRESS: N1265 PARK ROAD


SCALE: 1" = 30'

LEGEND

- FOUND IRON ROD
- FOUND IRON PIPE
- SET IRON PIPE

"I hereby certify that I have surveyed the above described property and that the above map is a correct representation thereof and shows the size and location of the property, its exterior boundaries, the location of all visible structures and dimensions of all principal buildings thereon, boundary fences, apparent easements, roadways and encroachments, if any."

"This survey is made for the use of the present owners of the property, and those who purchase, mortgage, or guarantee the title thereto within one year from date hereof."

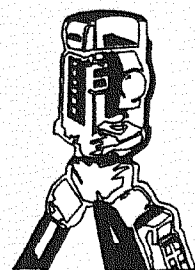

B.W. SURVEYING, INC.

LAND SURVEYS
MAPPING AND PLANNING
412 N. PINE STREET
BURLINGTON, WI 53105
(262)-767-0225

MAPLE

(40' WIDE)

100.00'

ROAD

250.00'

150.17'

EXISTING ASPHALT NOT
LOCATED DUE TO SNOW COVER

89°58'44"
(fld)

5.3'

PARK

(50' WIDE)

ROAD

(100.00')
99.91'

overhang



POST
OFFICE

overhead

utility

lines

90°00'00"
(fld)

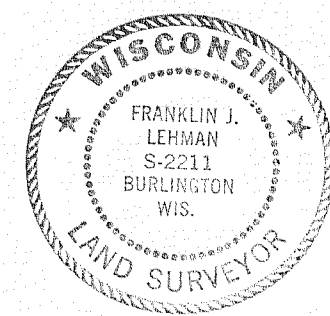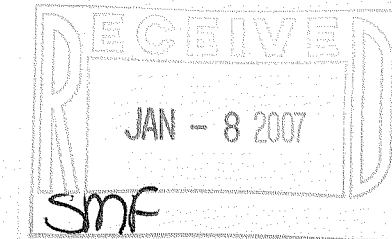

THIS IS NOT AN ORIGINAL PRINT
UNLESS THIS SEAL IS RED.

Franklin J. Lehman

FRANKLIN J. LEHMAN

S-2211

DECEMBER 7, 2005

DATE

7116

JOB NUMBER

MPL-223

118-2777