ASSIGNED NORTH LINE LOT 15
S 89'25'00" E

WORK ORDERED BY –
 BRIAN POLLARD – FAIRWYN
 875 TOWNLINE ROAD, SUITE 103
 LAKE GENEVA, WI 53147

## FARRIS, HANSEN & ASSOCIATES, INC.

ENGINEERING — ARCHITECTURE — SURVEYING
7 RIDGWAY COURT — P.O. BOX 437 — ELKHORN, WISCONSIN 53121
PHONE: (262) 723—2098 FAX: (262) 723—5886

## PLAT OF SURVEY

LOT 15 OF TUSCANY OF LAKE GENEVA, A SUBDIVISION LOCATED IN THE NW 1/4 OF SECTION 3, TOWN 1 NORTH, RANGE 18 EAST, WALWORTH COUNTY, WISCONSIN

LEGEND

O = FOUND IRON PIPE STAKE

\$XXX\$ = RECORDED AS






NOTE: COPIES OF THIS MAP TO WHICH THE FOLLOWING CERTIFICATE WILL APPLY SHOW THE SURVEYOR'S ORIGINAL SEAL AND SIGNATURE IN RED INK. COPIES BY ANY OTHER MEANS MAY HAVE ALTERATIONS WHICH DO NOT REPRESENT THE SURVEYOR'S WORK PRODUCT.

I HEREBY CERTIFY THAT THE ABOVE DESCRIBED PROPERTY HAS BEEN SURVEYED UNDER MY DIRECTION AND THAT THE ABOVE MAP IS A TRUE REPRESENTATION THEREOF AND SHOWS THE SIZE AND LOCATION OF THE PROPERTY, ITS EXTERIOR BOUNDARIES, THE LOCATION OF ALL VISIBLE STRUCTURES, AND DIMENSIONS OF ALL PRINCIPLE BUILDINGS THEREON, BOUNDARY FENCES, APPARENT EASEMENTS, ROADWAYS, AND VISIBLE ENCROACHMENTS, IF ANY. THIS SURVEY IS MADE FOR THE USE OF THE PRESENT OWNERS OF THE PROPERTY, AND ALSO THOSE WHO PURCHASE, MORTGAGE, OR GUARANTEE THE TITLE THERETO WITHIN ONE YEAR FROM THE DATE HEREOF.

DATED: FEBRUARY 12, 2007

PETER S. GORDON

## UNPLATTED LANDS

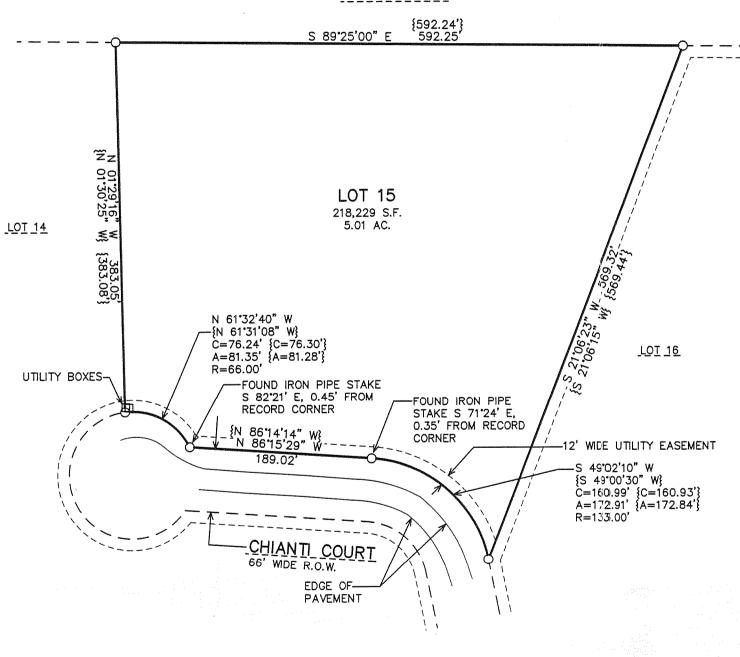

PROJECT: 7222 DATE: 02/12/2007 SHEET 1 OF 1 100 50 0 100 200 300 400

MAP SCALE IN FEET ORIGINAL 1"= 100'