
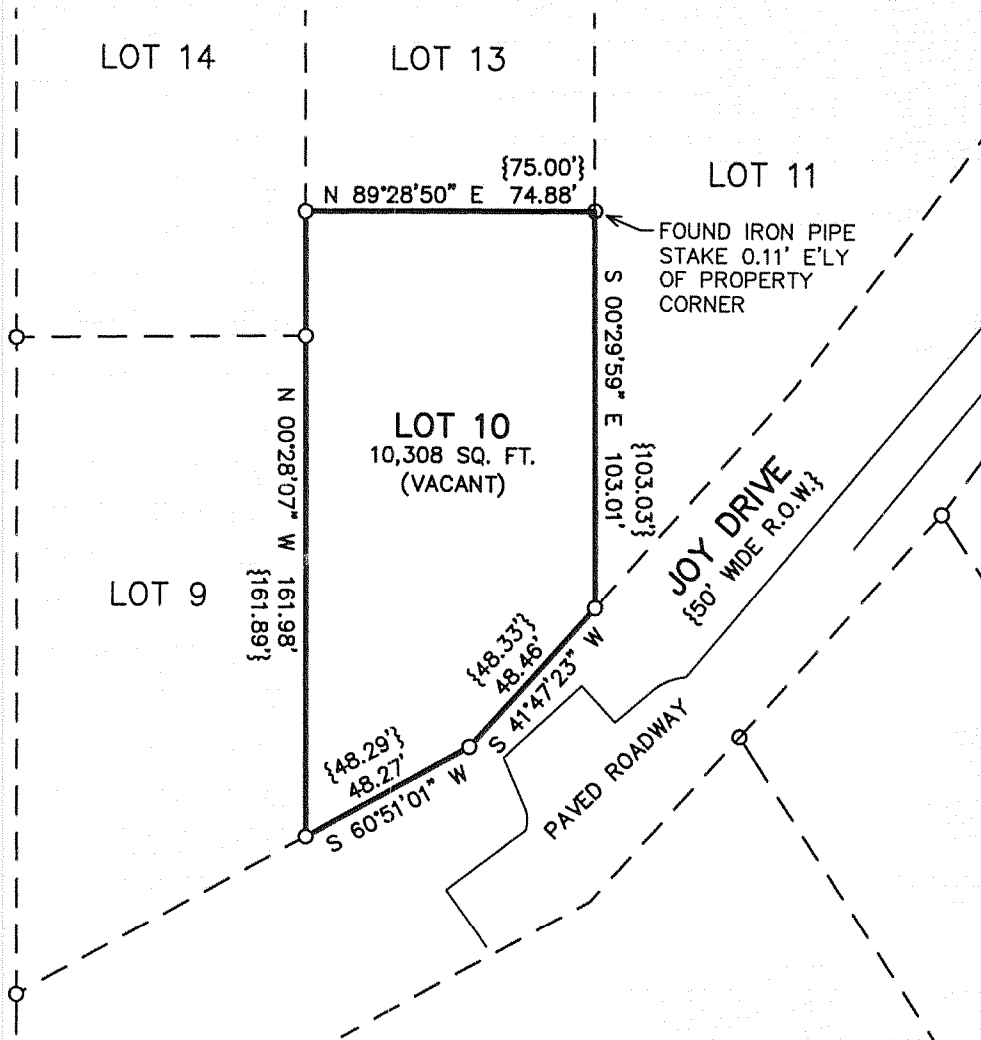



**FARRIS, HANSEN & ASSOCIATES, INC.**  
 ENGINEERING — ARCHITECTURE — SURVEYING  
 7 RIDGWAY COURT — P.O. BOX 437 — ELKHORN, WISCONSIN 53121  
 PHONE: (262) 723-2098 FAX: (262) 723-5886

**PLAT OF SURVEY**  
**LOT 10 OF LAKE TOMBEAU WOODS**  
 LOCATED IN PART OF THE SE 1/4 OF SECTION 24,  
 TOWN 1 NORTH, RANGE 18 EAST,  
 WALWORTH COUNTY, WISCONSIN

— WORK ORDERED BY —  
 JAMES McLENNAN  
 25 N. NORTHWEST HIGHWAY  
 PARK RIDGE, IL 60068

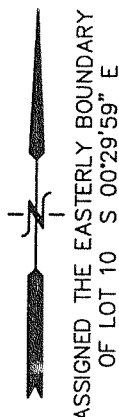


**LEGEND**  
 ○ = FOUND IRON PIPE STAKE  
 {xxx} = RECORDED AS

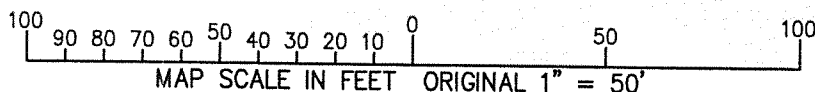


NOTE: COPIES OF THIS MAP TO WHICH THE FOLLOWING CERTIFICATE WILL APPLY SHOW THE SURVEYOR'S ORIGINAL SEAL AND SIGNATURE IN RED INK. COPIES BY ANY OTHER MEANS MAY HAVE ALTERATIONS WHICH DO NOT REPRESENT THE SURVEYOR'S WORK PRODUCT.

I HEREBY CERTIFY THAT THE ABOVE DESCRIBED PROPERTY HAS BEEN SURVEYED UNDER MY DIRECTION AND THAT THE ABOVE MAP IS A TRUE REPRESENTATION THEREOF AND SHOWS THE SIZE AND LOCATION OF THE PROPERTY AND ITS EXTERIOR BOUNDARIES. THIS SURVEY IS MADE FOR THE USE OF THE PRESENT OWNERS OF THE PROPERTY, AND ALSO THOSE WHO PURCHASE, MORTGAGE, OR GUARANTEE THE TITLE THERETO WITHIN ONE YEAR FROM THE DATE HEREOF.

DATED: 7/11/2007

  
 PETER S. GORDON R.L.S. 2101

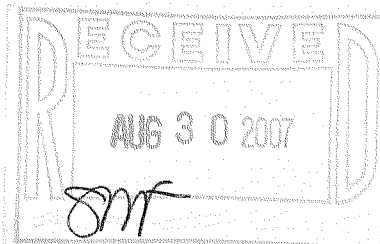

PROJECT: 7356  
 DATE: 07/11/2007  
 SHEET 1 OF 1