
PREPARED FOR LONGINO MENDOZA


## PLAT OF SURVEY

-OF-

LOTS 1546 THRU 1550, BLOCK 34 OF MAP OF SECTION 1 OF PELL LAKE SUBDIVISION, LOCATED IN TOWN 1 NORTH, RANGE 18 EAST, TOWN OF BLOOMFIELD, COUNTY OF WALWORTH AND STATE OF WISCONSIN. KROTT SURVEYING INC.

N3705 WILLOW BEND LANE LAKE GENEVA WI. 53147 PHONE # (262)248-3697 FAX # (262)249-0639

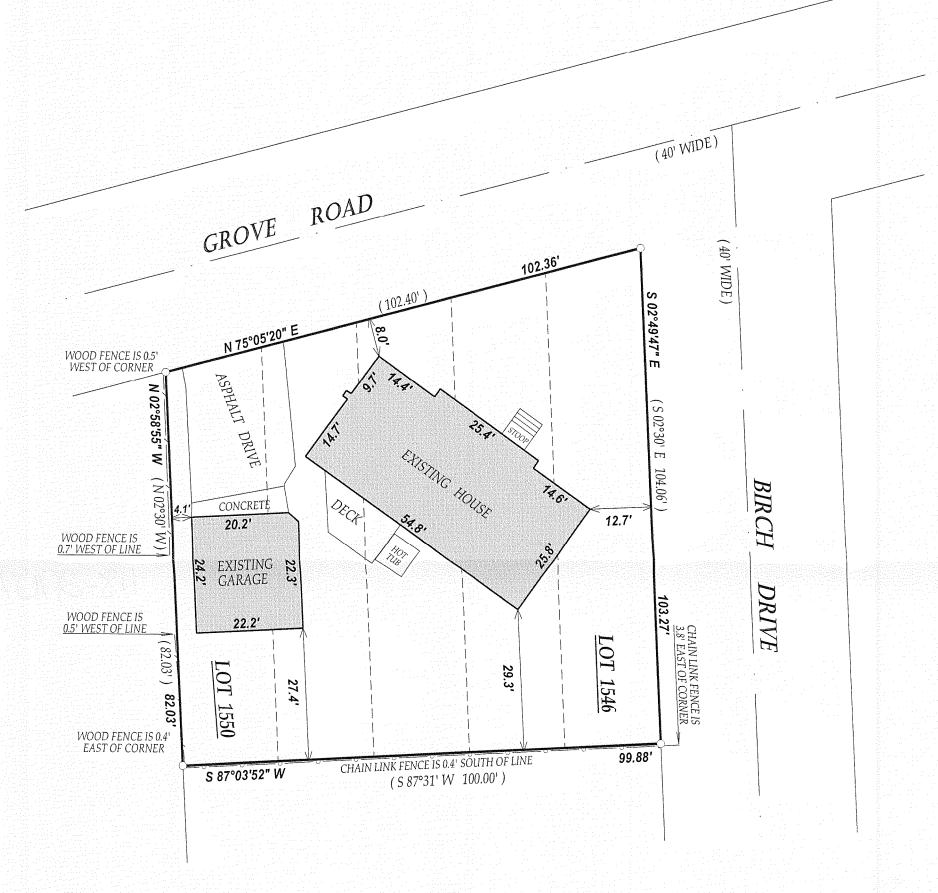

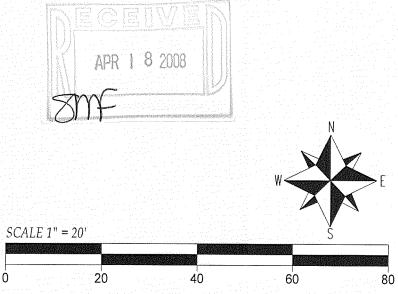

LEGEND

O FOUND IRON PIPE

(XX) RECORDED AS

JOB # 07-530 TAX ID # MPL00339
DATED THIS THE 20th DAY OF DECEMBER 2007.

COMPARE LEGAL DESCRIPTION ABOVE AND DRAWING WITH DEED. FOR BUILDING RESTRICTIONS AND EASEMENTS NOT SHOWN, REFER TO DEED, ABSTRACT SOURCES AND LOCAL MUNICIPAL CODES. NOTIFY THE SURVEYOR IMMEDIATELY OF ANY DISCREPANCY.

"I hereby certify that I have surveyed the above described property and that the above map is a true representation thereof and shows the size and location of all visible structures, apparent easements and encroachments if april."

This survey is made for the present owners of the property, and those who purchase, mortgage, or guarentee the title thereto, within one year from the date barrent

NOTE: BEARINGS ARE REFRENCED FROM THE ORIGINAL PLAT



John VPOTT S 2258

JOHN KROTT S - 2258 Wisconsin Registered Land Surveyor ( original if signed in red )

