


PLAT OF SURVEY

PARCEL 1:
Lots 1002 through 1006, inclusive, in Block 22, in the plat of Map of Section One of Pell Lake Subdivision, Town of Bloomfield, County of Walworth, State of Wisconsin.


PARCEL 2:
That part of the East 1/2 of the Northeast 1/4 of Section 21, T1N, R18E, Town of Bloomfield, County of Walworth, State of Wisconsin, described as follows: On the Northwest by the Southwesterly extension of the Northwesterly line of Lot 1006 in Pell Lake; on the Southeast by the Southwesterly extension of the Southeasterly line of Lot 1002 in Pell Lake; and on the Northeast and Southwest by lines parallel with and distant 100 feet Northeasterly and 50 feet Southwesterly, measured at right angles, from and centerline of the main tract (now removed) of the State Line and Union Rail Road Company (now the Chicago and North Western Transportation Company), as said main track centerline was originally located and established over and across said Section 21.

Tax Key No. MPL00222

LEGAL DESCRIPTION OF RECORD FROM TITLE COMMITMENT PROVIDED BY CLIENT

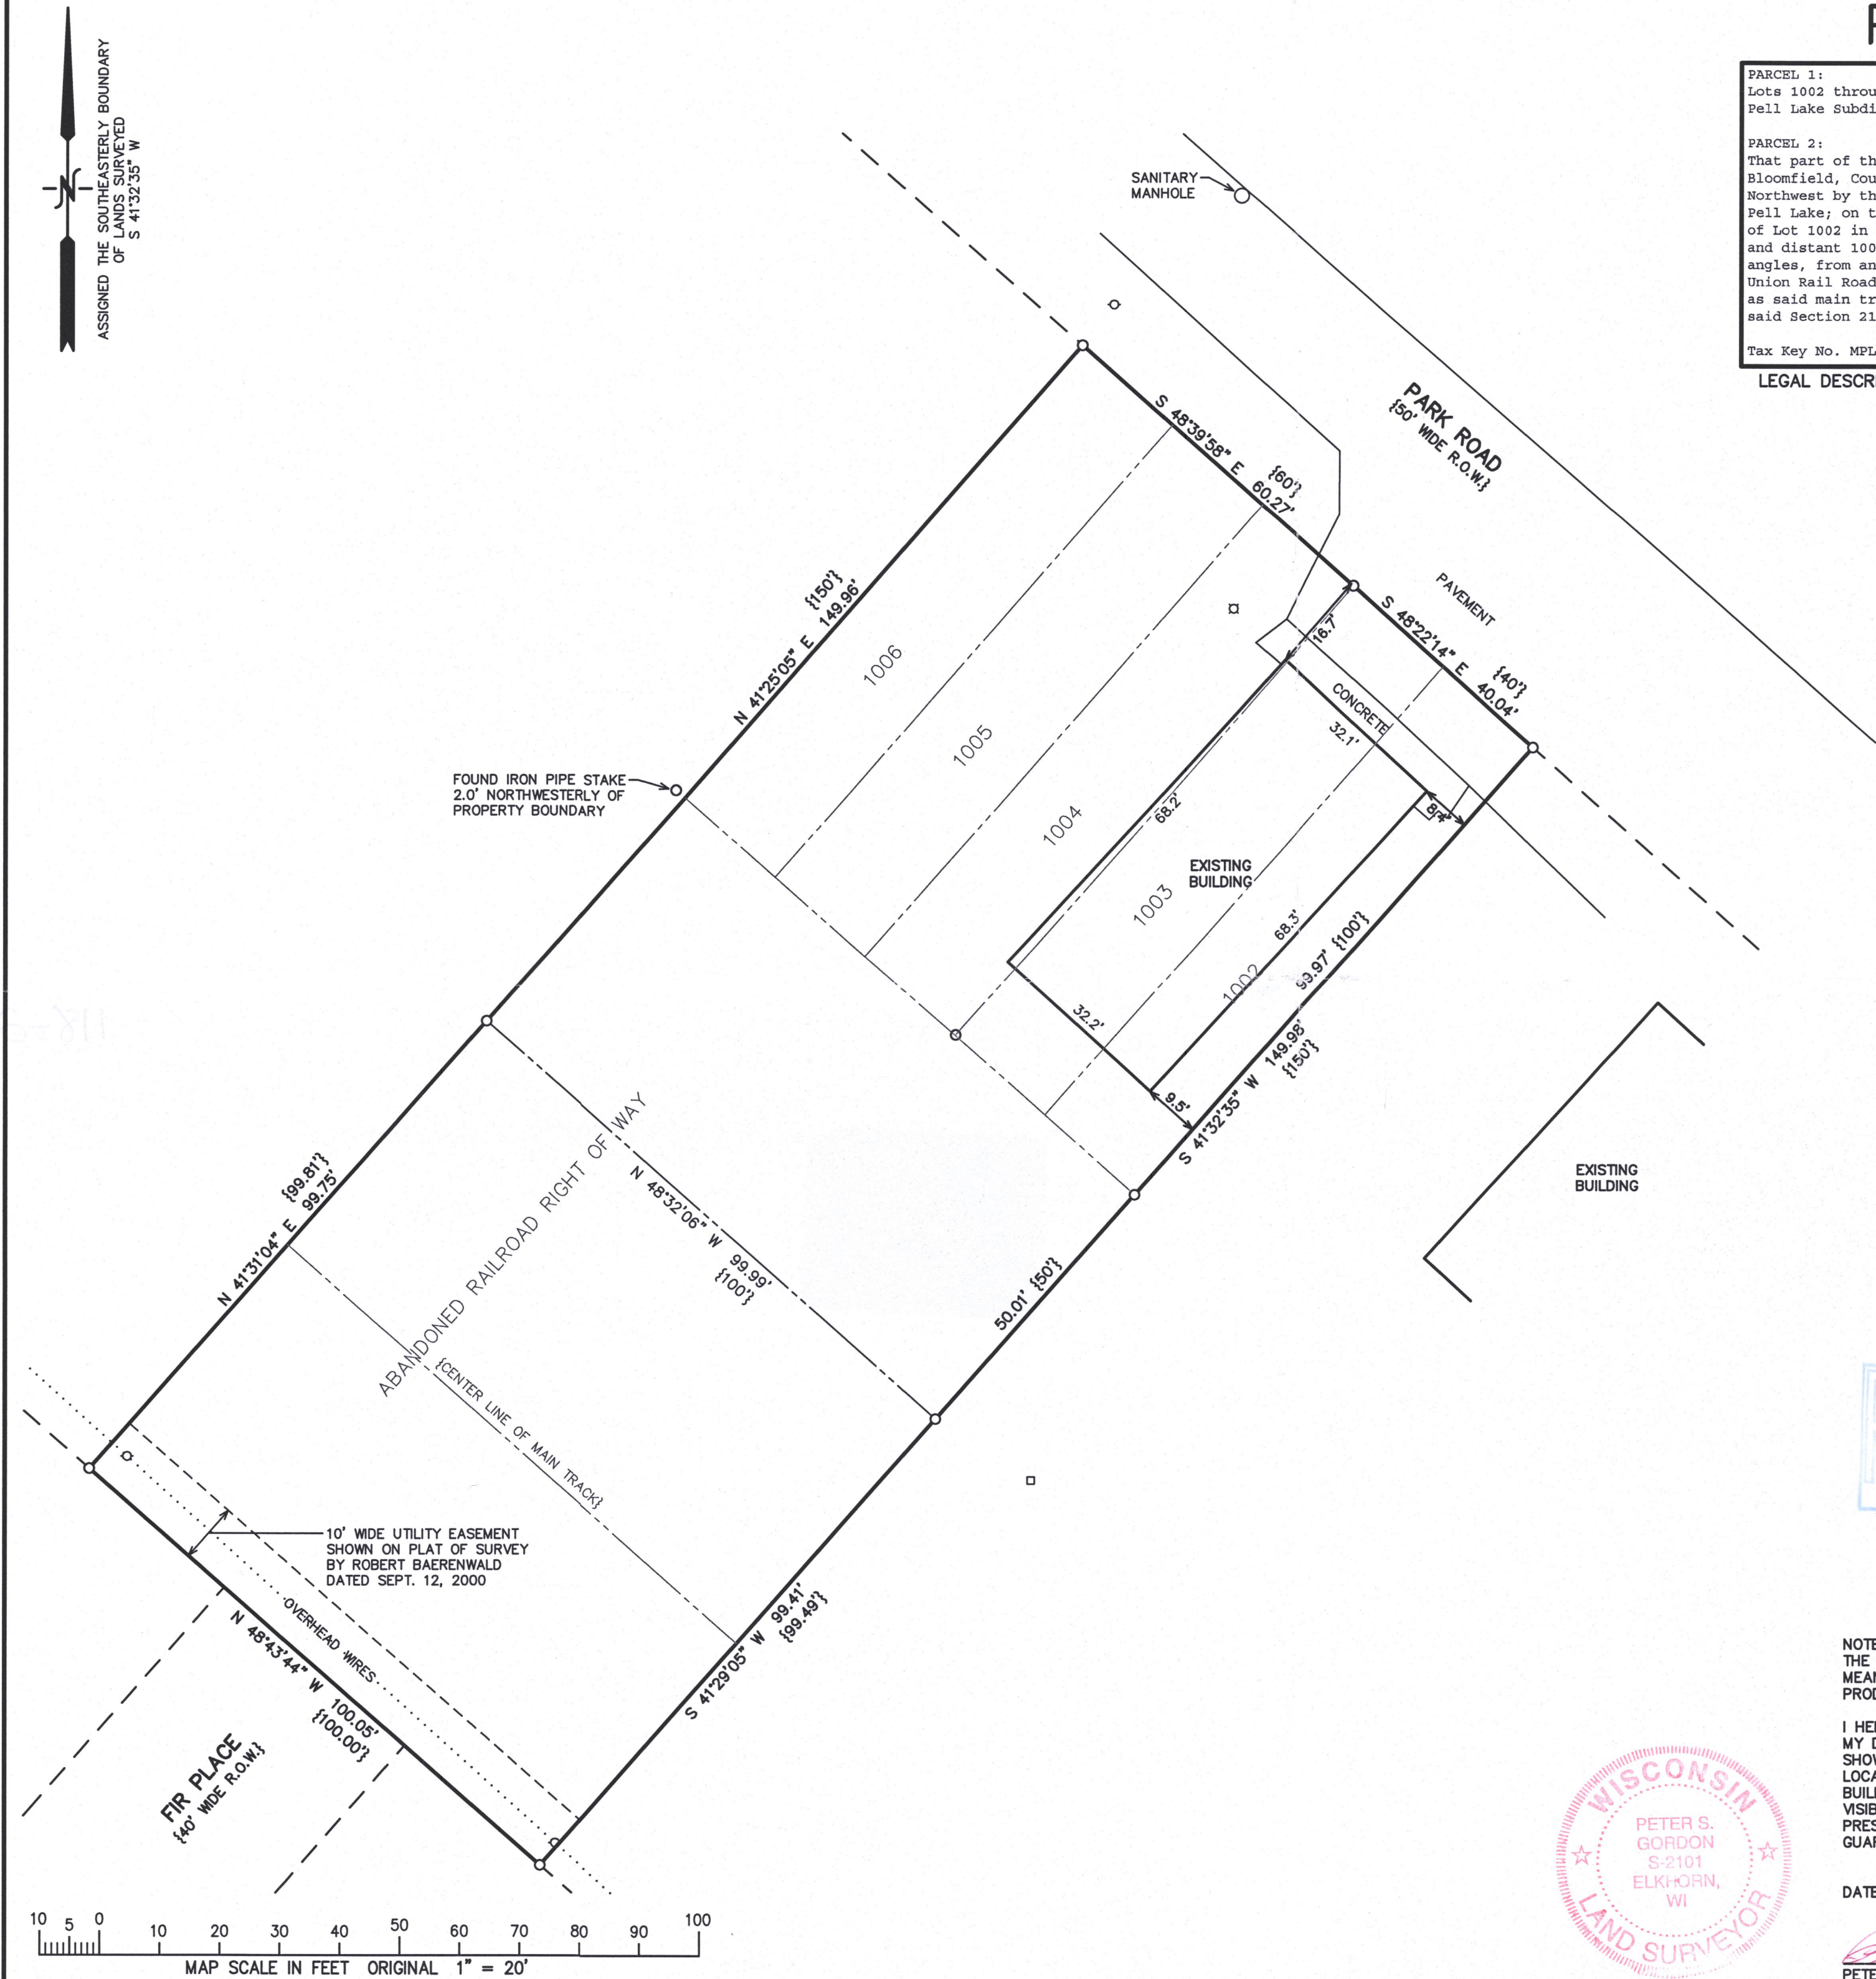

- LEGEND
- = FOUND IRON PIPE STAKE
 - ◇ = UTILITY POLE LOCATED
 - = LIGHT POLE LOCATED
 - = UTILITY BOX LOCATED
 - {XXX} = RECORDED AS

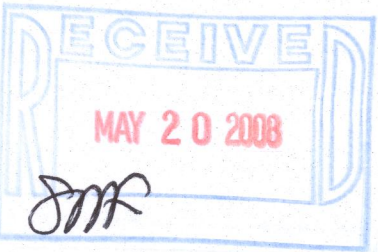

NOTE: COPIES OF THIS MAP TO WHICH THE FOLLOWING CERTIFICATE WILL APPLY SHOW THE SURVEYOR'S ORIGINAL SEAL AND SIGNATURE IN RED INK. COPIES BY ANY OTHER MEANS MAY HAVE ALTERATIONS WHICH DO NOT REPRESENT THE SURVEYOR'S WORK PRODUCT.

I HEREBY CERTIFY THAT THE ABOVE DESCRIBED PROPERTY HAS BEEN SURVEYED UNDER MY DIRECTION AND THAT THE ABOVE MAP IS A TRUE REPRESENTATION THEREOF AND SHOWS THE SIZE AND LOCATION OF THE PROPERTY, ITS EXTERIOR BOUNDARIES, THE LOCATION OF ALL VISIBLE STRUCTURES, AND DIMENSIONS OF ALL PRINCIPLE BUILDINGS THEREON, BOUNDARY FENCES, APPARENT EASEMENTS, ROADWAYS, AND VISIBLE ENCROACHMENTS, IF ANY. THIS SURVEY IS MADE FOR THE USE OF THE PRESENT OWNERS OF THE PROPERTY, AND ALSO THOSE WHO PURCHASE, MORTGAGE, OR GUARANTEE THE TITLE THERETO WITHIN ONE YEAR FROM THE DATE HEREOF.

DATED: 5/16/2008

PETER S. GORDON



PLAT OF SURVEY

WORK ORDERED BY -
STELLING & ASSOCIATES ARCHITECTS
181 W. CHESTNUT STREET
BURLINGTON, WI 53105

FARRIS, HANSEN & ASSOCIATES, INC.
ENGINEERING - ARCHITECTURE - SURVEYING
7 RIDGWAY COURT P.O. BOX 437
ELKHORN, WISCONSIN 53121
OFFICE: (262) 723-2098 FAX: (262) 723-5686

REVISIONS

PROJECT NO.
7636
DATE:
05/16/2008
SHEET NO.
1 OF 1

MPL - 222

118-2914