


HAROLD H. KOLB


REGISTERED PROFESSIONAL LAND SURVEYOR
LAKE GENEVA, WISCONSIN

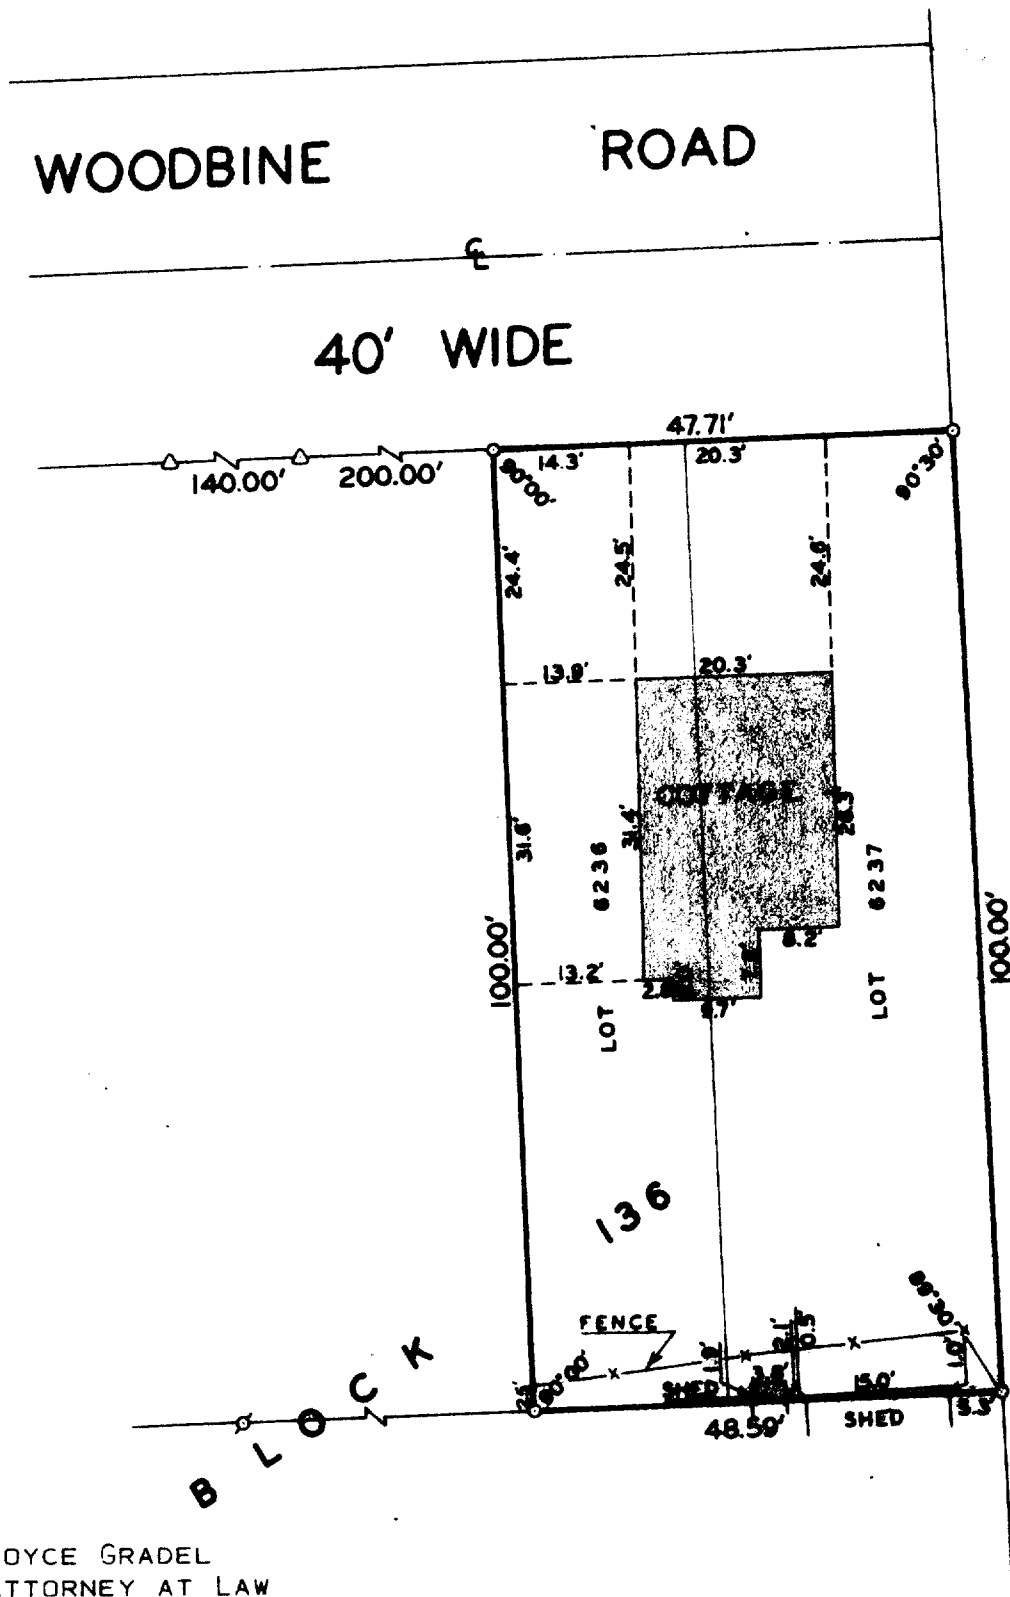

ORDERED BY: JOYCE GRADEL
ATTORNEY AT LAW
715 LAKE STREET
OAK PARK, IL 60301

PLAT OF SURVEY OF

LOTS 6236 AND 6237, BLOCK 136, PELL LAKE
SUBDIVISION, TOWN 1 NORTH, RANGE 18 EAST,
WALWORTH COUNTY, WISCONSIN.

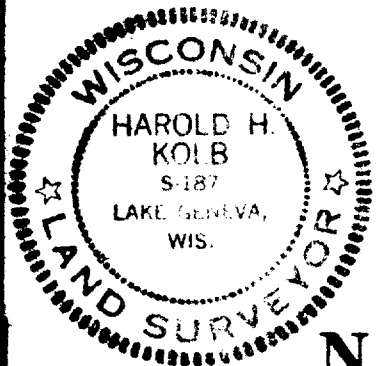

N



SCALE: 1" = 20'
LEGEND

- O - IRON PIPE PLACED. 1" x 24" 1.13 LB./LIN. FT.
- Ø - IRON PIPE FOUND
- Δ - IRON ROD FOUND

I, HAROLD H. KOLB, DO HEREBY CERTIFY THAT I HAVE
SURVEYED THE PROPERTY HEREON DESCRIBED ACCORDING
TO THE OFFICIAL RECORDS, AND THAT THE PLAT HEREON
IS A CORRECT REPRESENTATION OF THE LOT LINES.

Harold H. Kolb

HAROLD H. KOLB
WISCONSIN REGISTERED LAND SURVEYOR, S-187
DATE Aug 1, 1978