PREPARED FOR: IACK GOODMAN

■ SET IRON BAR

(XX) RECORDED AS

JOB # 08-145 TAX PD # MPLA 00192

DATED THIS THE 10th DAY OF OCTOBER 2008.

SURVEY PLAT OF


-OF-

LOTS 942 THRU 950 BLOCK 16, PELL LAKE ADDITION LOCATED IN TOWN 1 NORTH, RANGE 18 EAST, WALWORTH COUNTY, WISCONSIN

KROTT SURVEYING INC. N3705 WILLOW BEND LANE LAKE GENEVA WI. 53147 PHONE # (262)248-3697 FAX # (262)249-0639

C.L. CAMELIA ROAD

SCALE 1"=20"

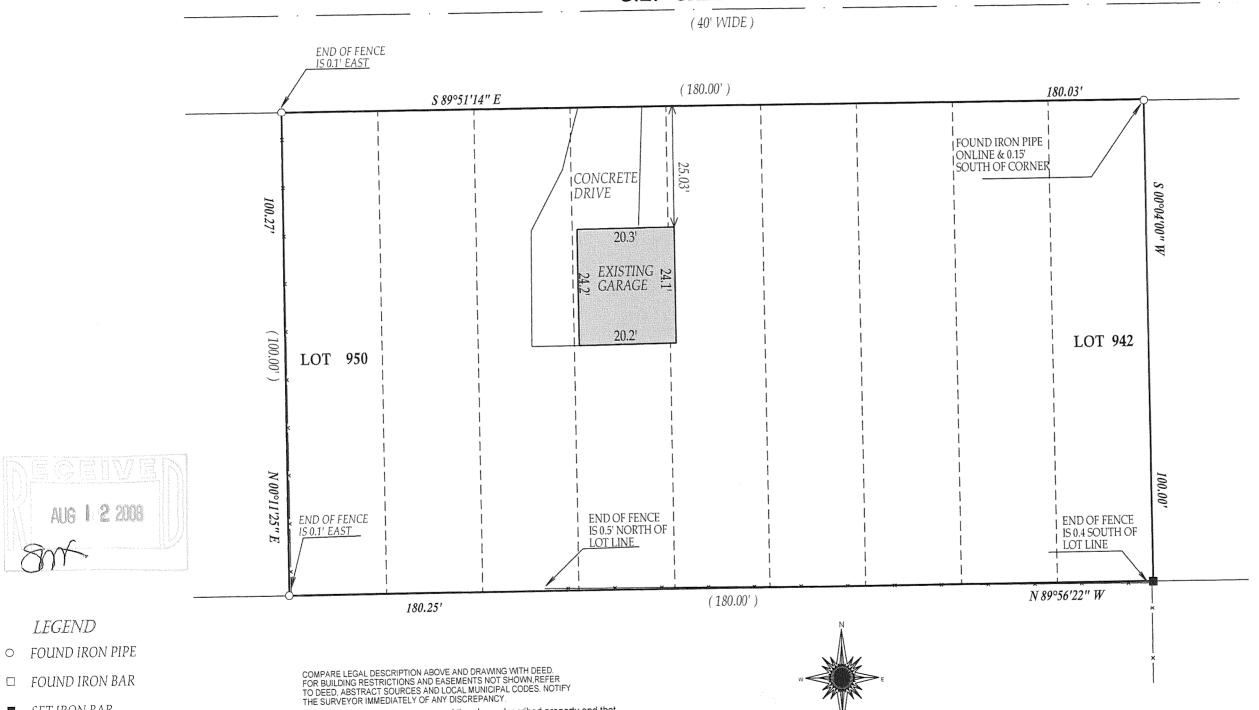


"I hereby certify that I have surveyed the above described property and that the above map is a true representation thereof and shows the size and

location of all visible structures, apparent easements and encroachments

This survey is made for the present owners of the property, and those who purchase, mortgage, or guarentee the title thereto, within one year from

the date hereof.

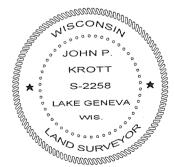

DATED THIS 30th, DAY OF JUNE, 2008

JOHN KROTT S - 2258 Wisconsin Registered Land Surveyor

(original if signed in red)

118-2926