
PREPARED FOR: PATRICK REDENZ P.O. BOX 385 PELL LAKE, WI 53157

## PLAT OF SURVEY

- OF

LOTS 3604 THRU 3609 IN BLOCK 75 OF PELL LAKE SUBDIVISION, LOCATED IN TOWN I NORTH, RANGE 18 EAST, TOWN OF BLOOMFIELD, WALWORTH COUNTY, WISCONSIN. KROTT SURVEYING, INC. N3705 WILLOW BEND LANE LAKE GENEVA, WI 53147 (262)- 248-3697

## EAU CLAIRE ROAD

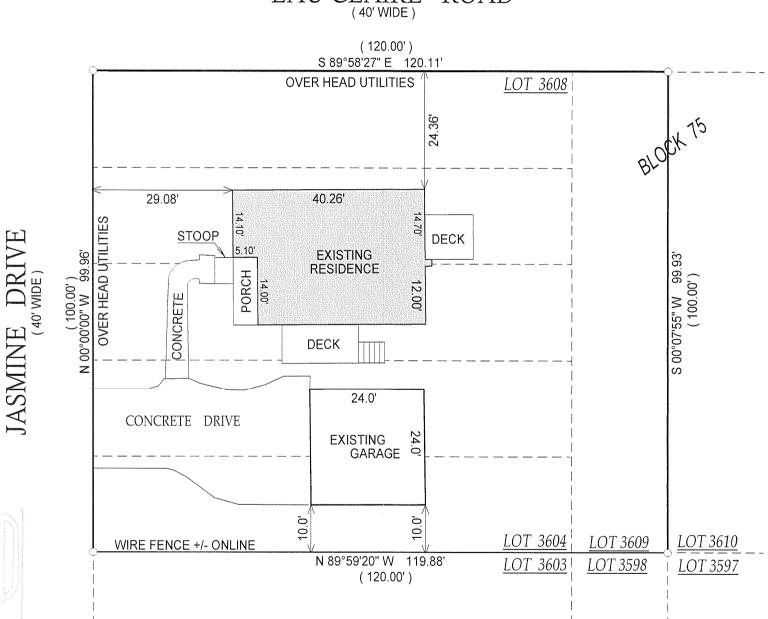

() = RECORDED AS

 $\Box$  = FOUND IRON BAR

○ = FOUND IRON PIPE

■ = SET IRON BAR

● = SET IRON PIPE

SCALE: 1" = 20'

IOB #: 07-392AB

TAXID #: MPL 00752

NOTE: BASIS OF BEARING IS JASIMNE DRIVE ASSUMED NORTH - SOUTH.

COMPARE LEGAL DESCRIPTION ABOVE AND DRAWING WITH DEED. FOR BUILDING RESTRICTIONS AND EASEMENTS NOT SHOWN, REFER TO DEED. ABSTRACT SOURCES AND LOCAL MUNICIPAL CODES. NOTIFY THE SURVEYOR IMMEDIATELY OF ANY DISCREPANCY.

AIG 1 2 200

"I hereby certify that I have surveyed the above described property and that the above map, to the best of my knowledge and belief, is a true representation thereof and shows the size and location of all visible structures, apparent easements and encroachments if any."

This survey is made for the present owners of the property, and those who purchase, mortgage, or guarantee the title thereto, within one year from the date hereof.



DATED THIS 19th, DAY OF MAY, 2008

JOHN KROTT S - 2258 Wisconsin Registered Land Surveyor ( original if signed in red )

118-2934