
PLAT OF SURVEY -OF-

LOTS 6577 THRU 6581, BLOCK 143, PELL LAKE SECTION 4 SUBDIVISION, ACCORDING TO THE RECORDED PLAT THEREOF. SAID LAND BEING IN THE TOWN OF BLOOMFIELD, COUNTY OF WALWORTH, STATE OF WISCONSIN.


SURVEY FOR: BETH BURI



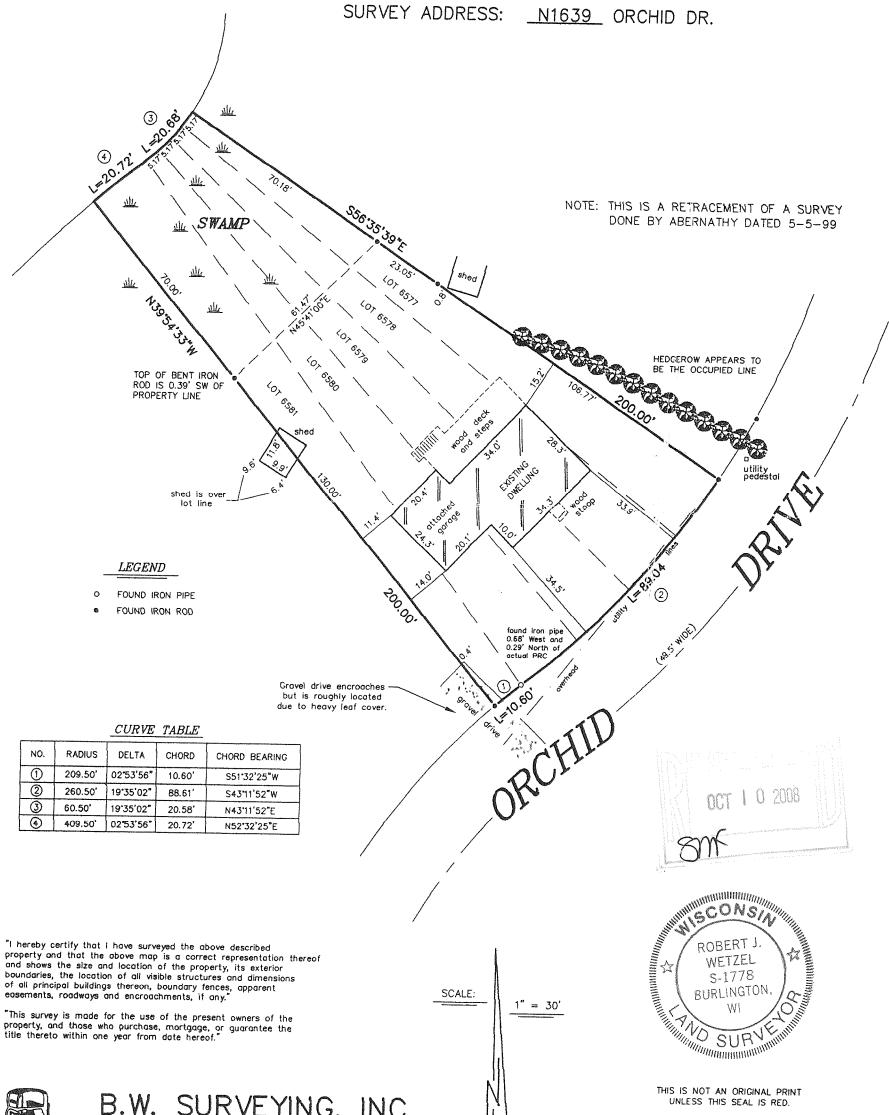

B.W. SURVEYING, INC.

LAND SURVEYS MAPPING AND PLANNING 412 N. PINE STREET BURLINGTON, WI 53105 (262) - 767 - 0225

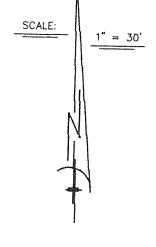

ROBERT J. WETZE

THIS IS NOT AN ORIGINAL PRINT

UNLESS THIS SEAL IS RED.

REVISED: JUNE 22, 2007 MAY 16, 2007 DATE

JOB NUMBER

REVISED: APRIL 24, 2008

MPL-1437

118-2942