


071099  
071099S1.DWG



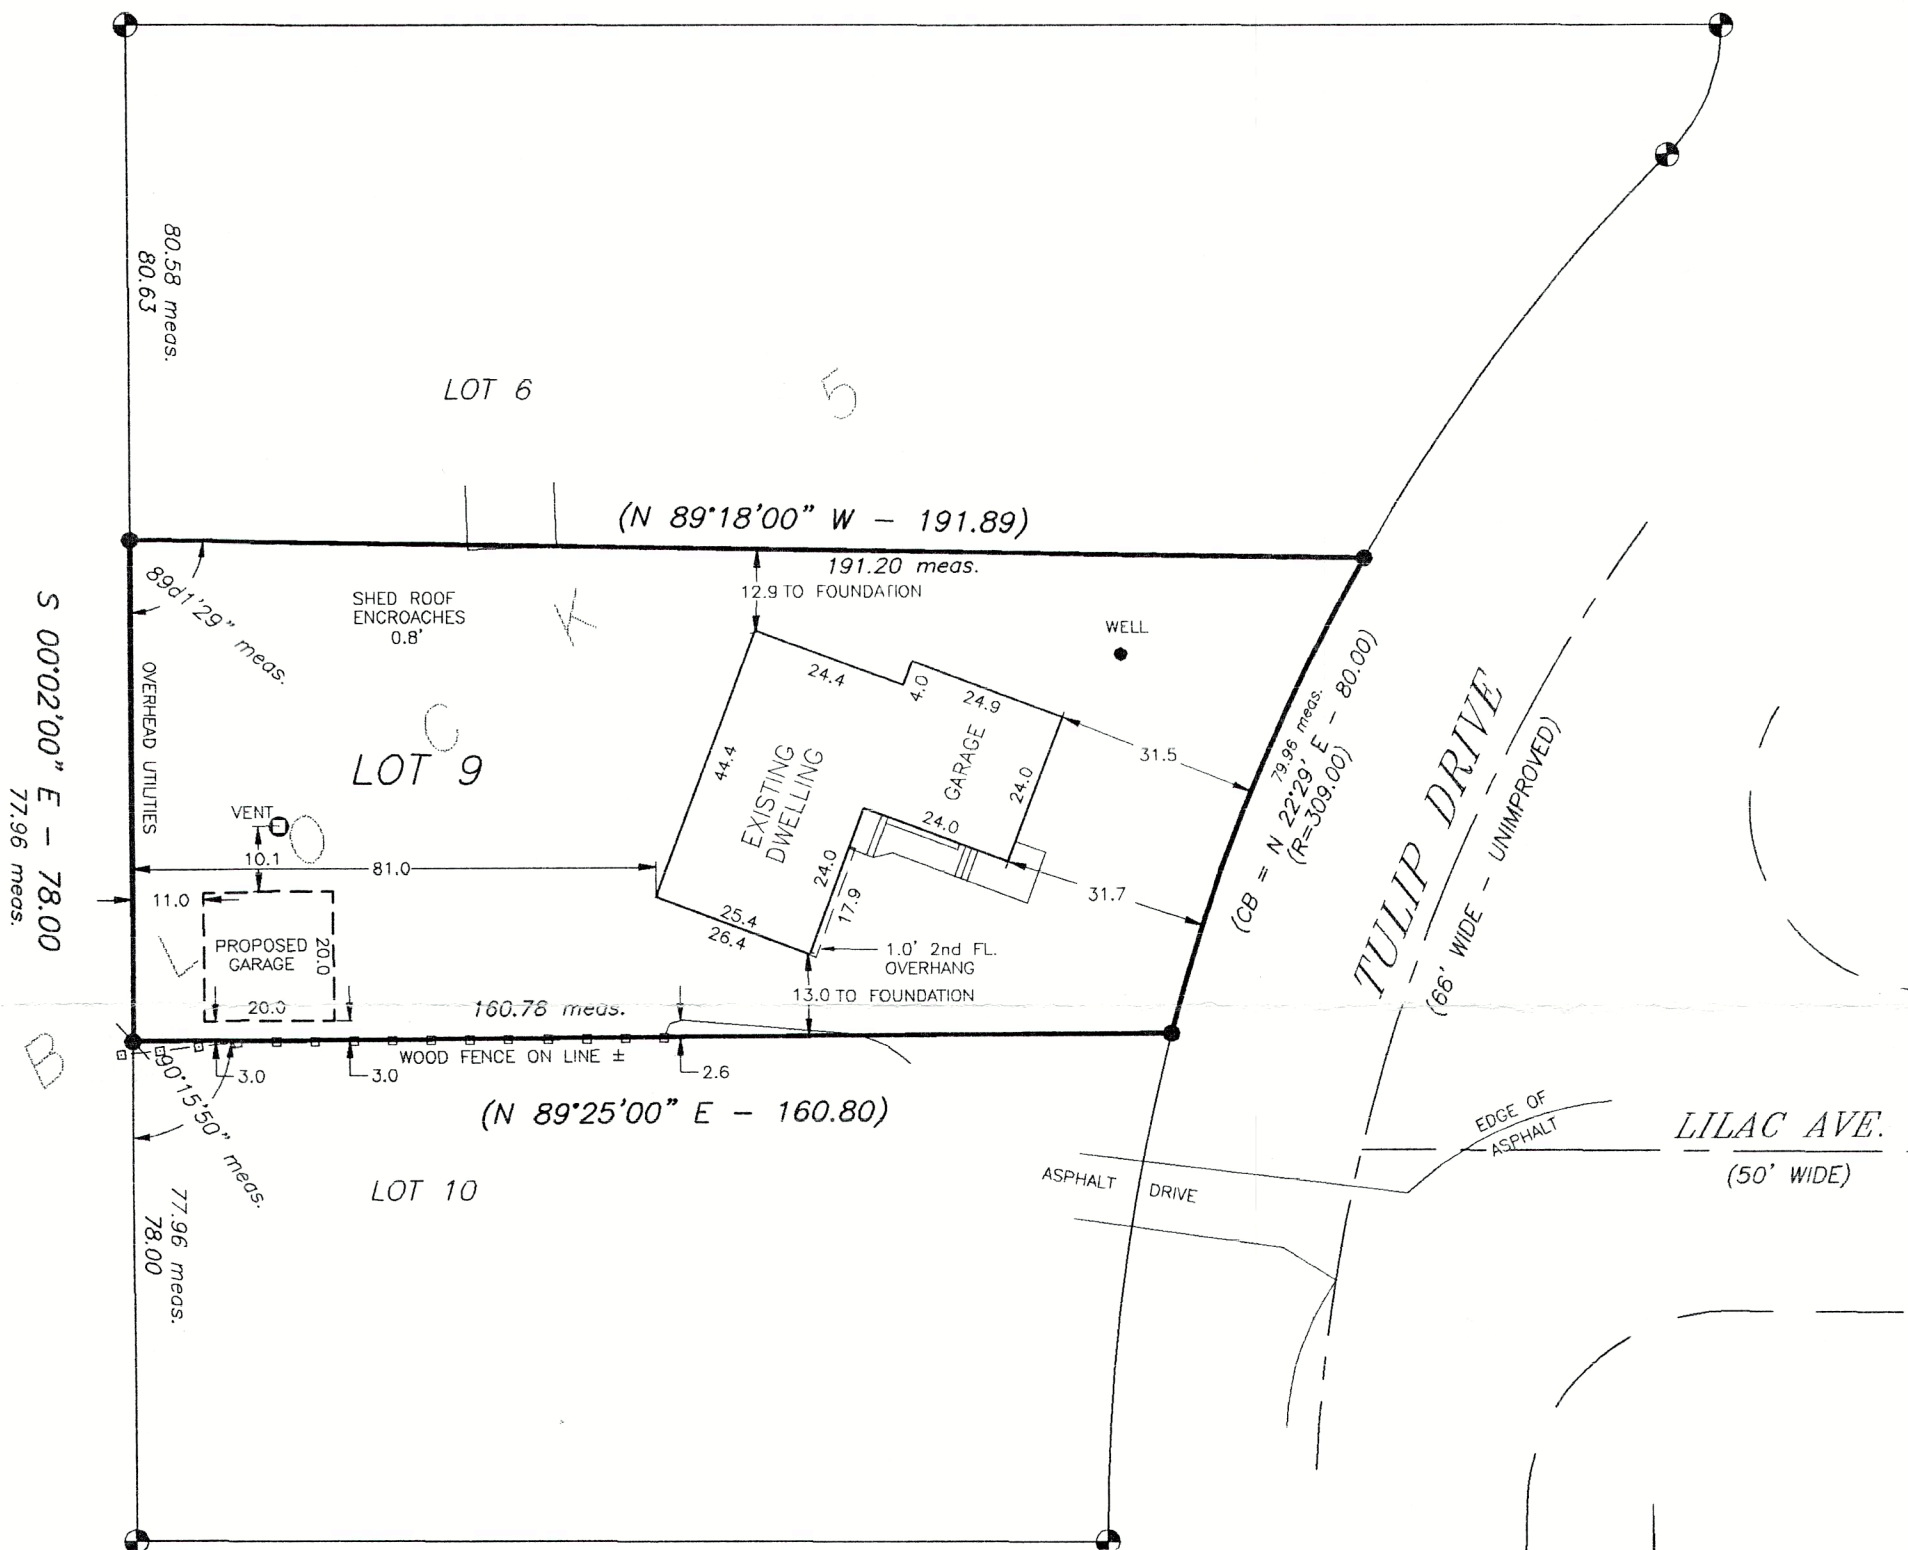


 
PLAT OF SURVEY

\* REFER TO CURRENT TITLE REPORT FOR EASEMENTS, RESTRICTIONS OR COVENANTS OF RECORD THAT MAY AFFECT THIS LAND \*


\* ESPECIALLY THOSE NOT SHOWN ON THE RECORDED PLAT OF ROSE NIPPERSINK GARDENS SUBDIVISION \*



### LEGEND

-  — FOUND IRON PIPE  
 — FOUND SOLID IRON BAR  
 — SET IRON PIPE  
 — FENCE  
 — RECORDED AS  
 — FOUND CONCRETE MONUMENT

BEARING BASE: AS RECORDED AS.

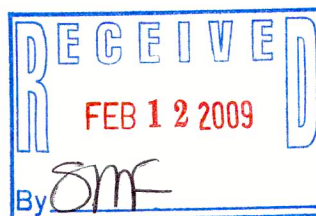

I HEREBY CERTIFY THAT I HAVE SURVEYED THE ABOVE DESCRIBED PROPERTY AND THE ABOVE MAP IS A TRUE REPRESENTATION THEREOF AND SHOWS THE SIZE AND LOCATION OF THE PROPERTY, THE LOCATION OF ALL VISIBLE STRUCTURES AND DIMENSIONS OF ALL PRINCIPAL BUILDINGS THEREON, BOUNDARY FENCES, APPARENT EASEMENTS, ROADWAY AND VISIBLE ENCROACHMENTS, IF ANY.

THIS SURVEY IS MADE FOR THE PRESENT OWNERS OF THE PROPERTY, AND ALSO THOSE WHO PURCHASE, OR GUARANTEE THE TITLE THERETO WITHIN (1) YEAR FROM THE DATE HEREOF.

DATED AT WATERFORD, WI THIS 3rd DAY OF JULY 2007

Revised:  
October 21st, 2008

RECERTIFIED

MRNG - 44

118-2960