

Plat of Survey

of


Lot 31 of Willow Estates, A Subdivision,

located in the Northeast 1/4 of Section 15, Town 1 North, Range 18 East, Town of Bloomfield, Walworth County, Wisconsin.



Surveyed for:

The Rauland Agency, Inc.

118 Kenosha Street * P.O. Box 159
Walworth, Wisconsin. 53184

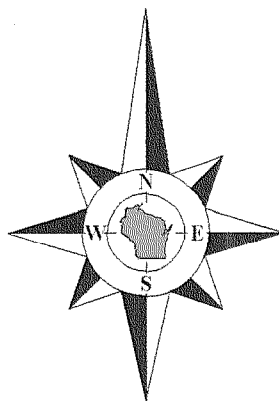

Bearings reference to the the East line of
Overlook Drive, recorded as N1°43'20"W
on the plat of Willow Estates, A Subdivision.

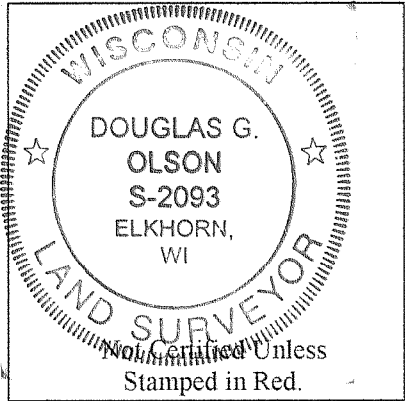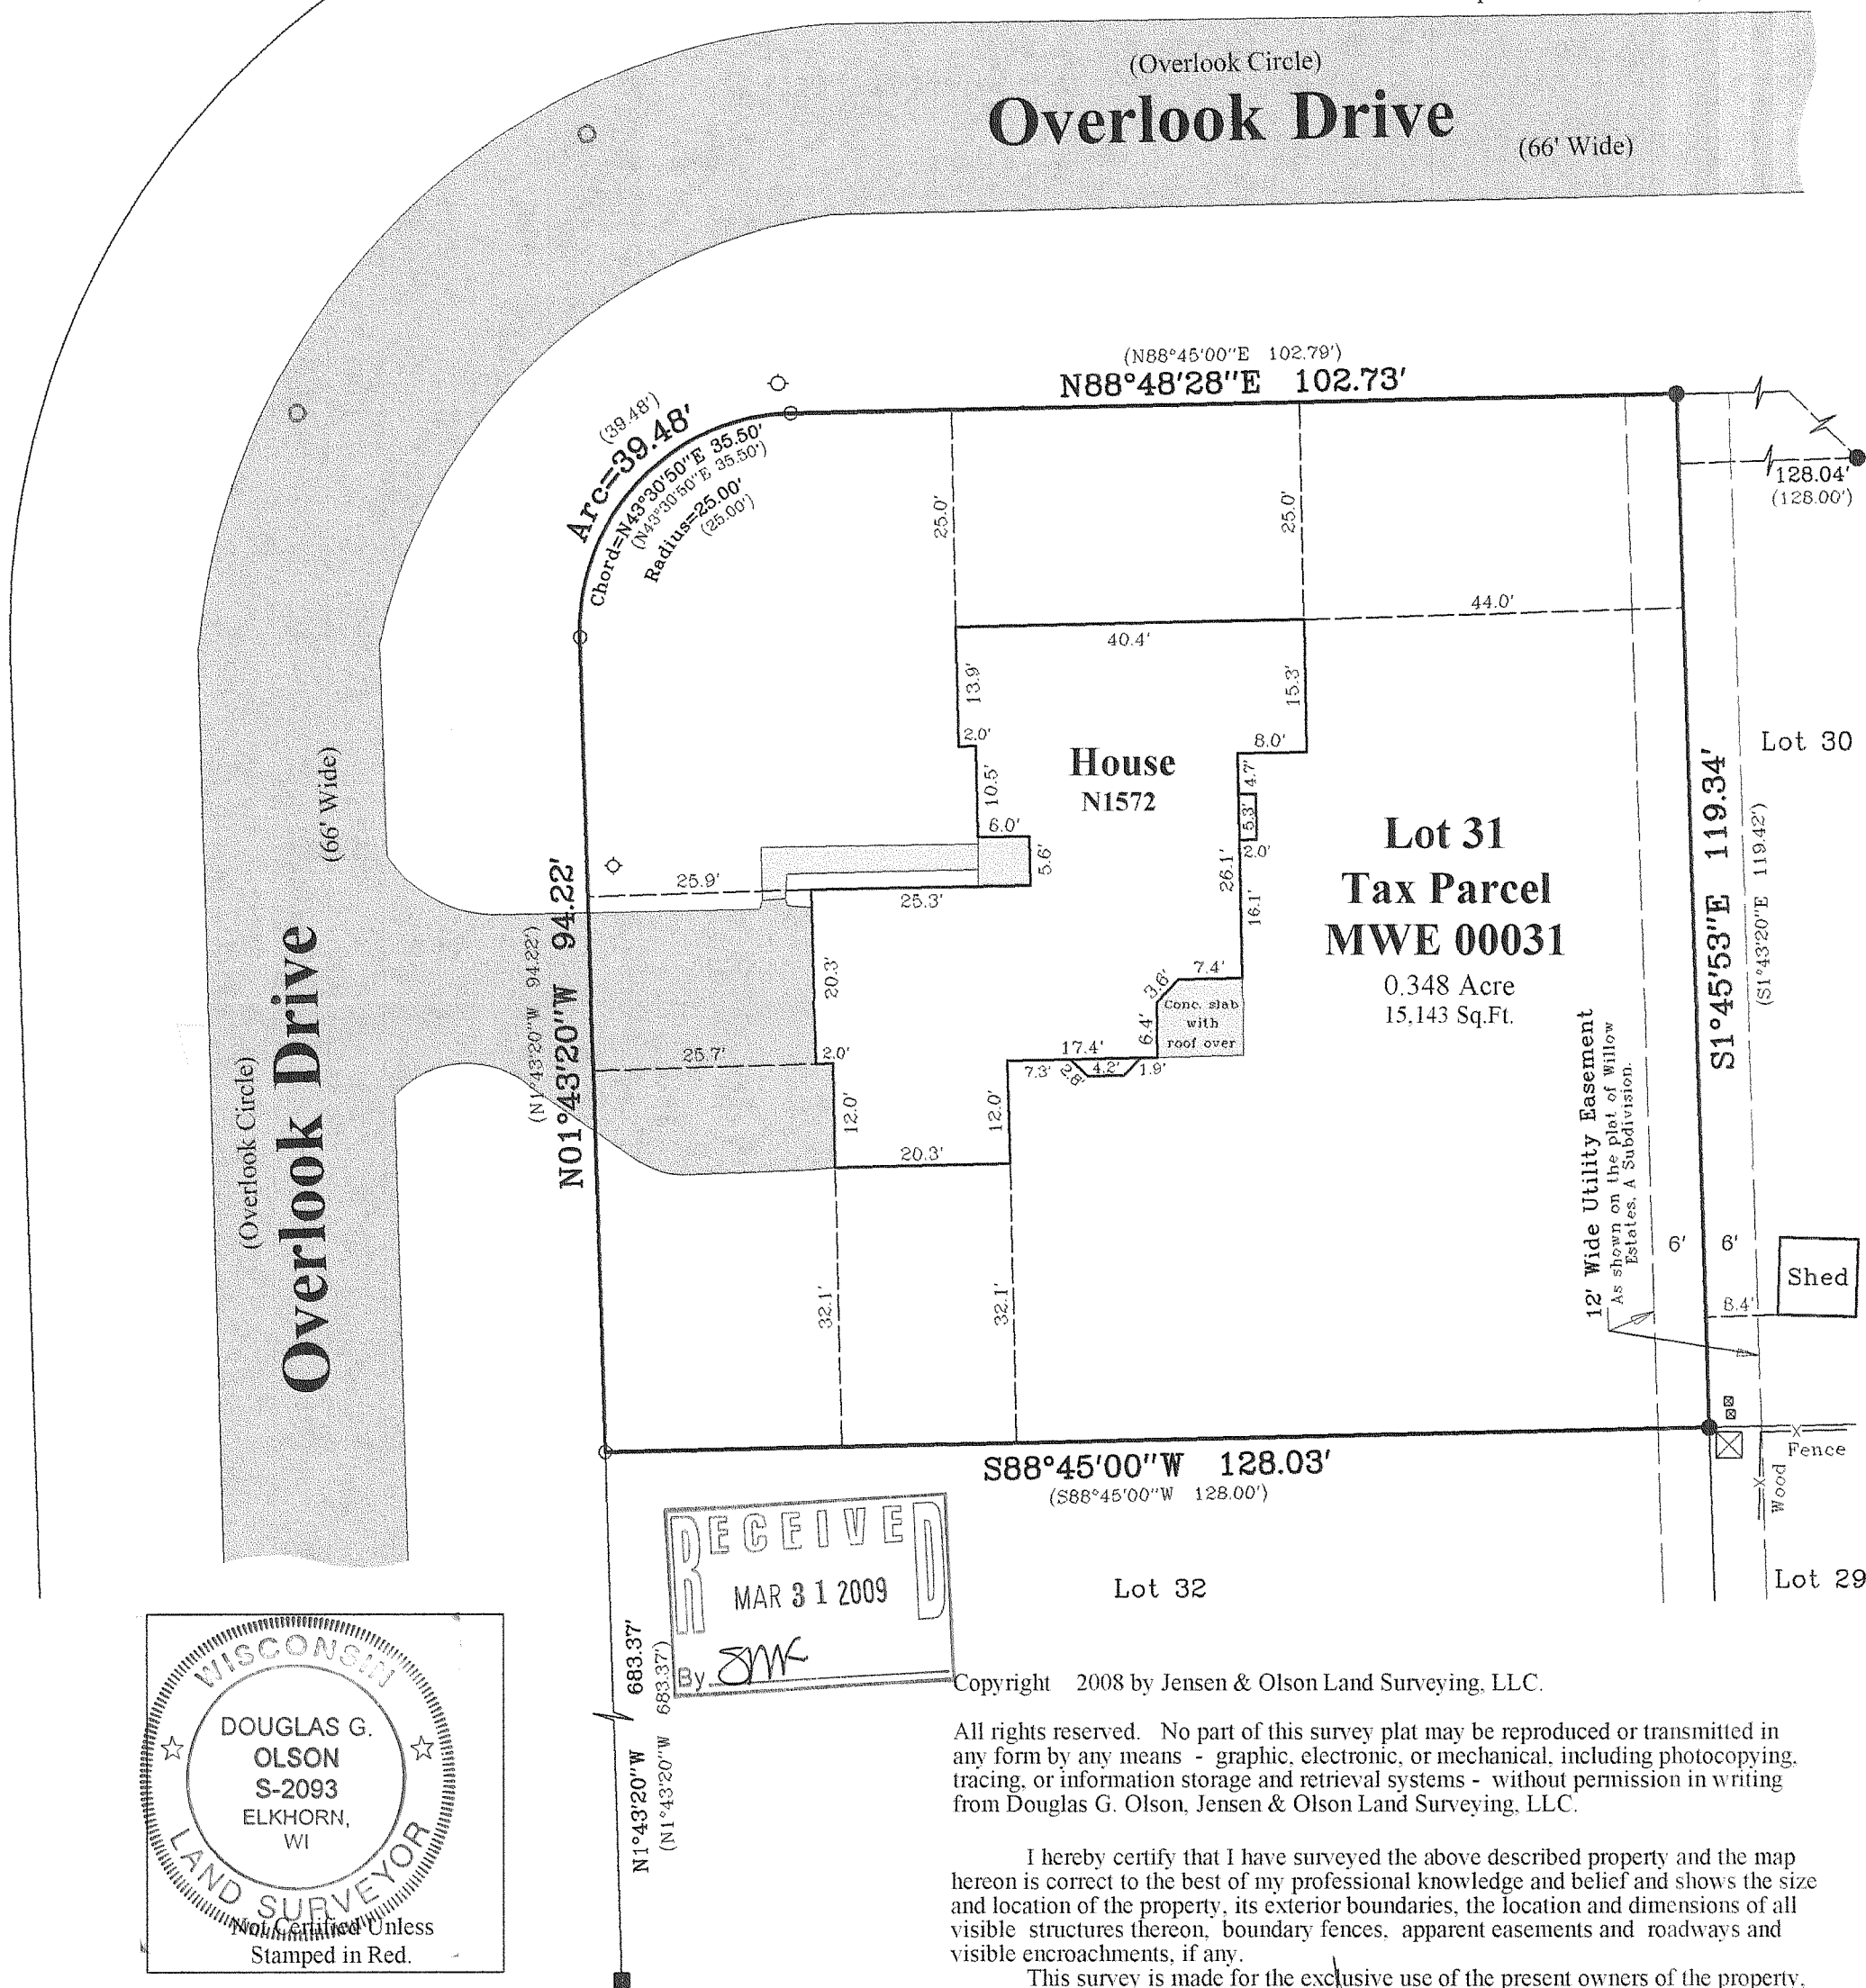

Notes:

- 1) This survey plat is not certified unless signed and sealed in red ink.
- 2) This survey is subject to Wisconsin lien laws. This Plat of Survey is the notice of intent to file lien. Lien waiver required.

Copyright 2008 by Jensen & Olson Land Surveying, LLC.

All rights reserved. No part of this survey plat may be reproduced or transmitted in any form by any means - graphic, electronic, or mechanical, including photocopying, tracing, or information storage and retrieval systems - without permission in writing from Douglas G. Olson, Jensen & Olson Land Surveying, LLC.

I hereby certify that I have surveyed the above described property and the map hereon is correct to the best of my professional knowledge and belief and shows the size and location of the property, its exterior boundaries, the location and dimensions of all visible structures thereon, boundary fences, apparent easements and roadways and visible encroachments, if any.

This survey is made for the exclusive use of the present owners of the property, and also those who purchase, mortgage or guarantee title thereto, within one year from the date hereof.

Douglas G. Olson
Wisconsin Registered Land Surveyor - 2093

Legend

- Found Iron Rod, 1-5/16" dia.
- Found Iron Rod, 3/4" dia.
- Set Iron Rod, 3/4" dia.
- () Recorded Information
- Fire Hydrant
- Water Valve
- Manhole
- Utility Box or Pedestal
- Asphalt Surface
- Concrete Surface



Jensen & Olson Land Surveying, LLC

45 South Wisconsin Street * P.O. Box 322 * Elkhorn, Wisconsin. 53121

Telephone: (262) 723-3434 * Facsimile: (262) 723-8044

Email: jensen.olson@elknet.net

Scale: 1" = 20'



Survey date: January 8, 2009.

Revisions:

Sheet 1 of 1 Sheets.

Job Reference Number:

2008.130

MWE - 31

118 - 29167