


PREPARED FOR:
 MAIA WILSON
 LAKE GENEVA AREA REALTY
 101 BROAD ST. SUITE C3
 LAKE GENEVA, WI 53147

PLAT OF SURVEY

- OF -

PATHFINDER SURVEYING, INC.
 W2888 KRUEGER ROAD UNIT "D"
 LAKE GENEVA, WI 53147
 (262) 248-8303


LOTS 1928, 1929, 1930, 1931, 1932, 1933, AND 1934, BLOCK 60, OF SECTION 2 OF PELL LAKE
 SUBDIVISION, BEING A PART OF SECTION 22, TOWN 1 NORTH, RANGE 18 EAST, TOWN OF BLOOMFIELD,
 WALWORTH COUNTY, WISCONSIN.

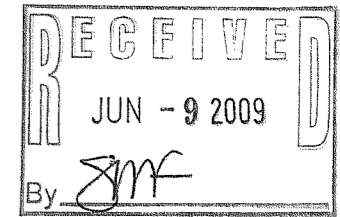

EVERGREEN DRIVE

LAUREL DRIVE
 (40' WIDE)

ROSEWOOD DRIVE

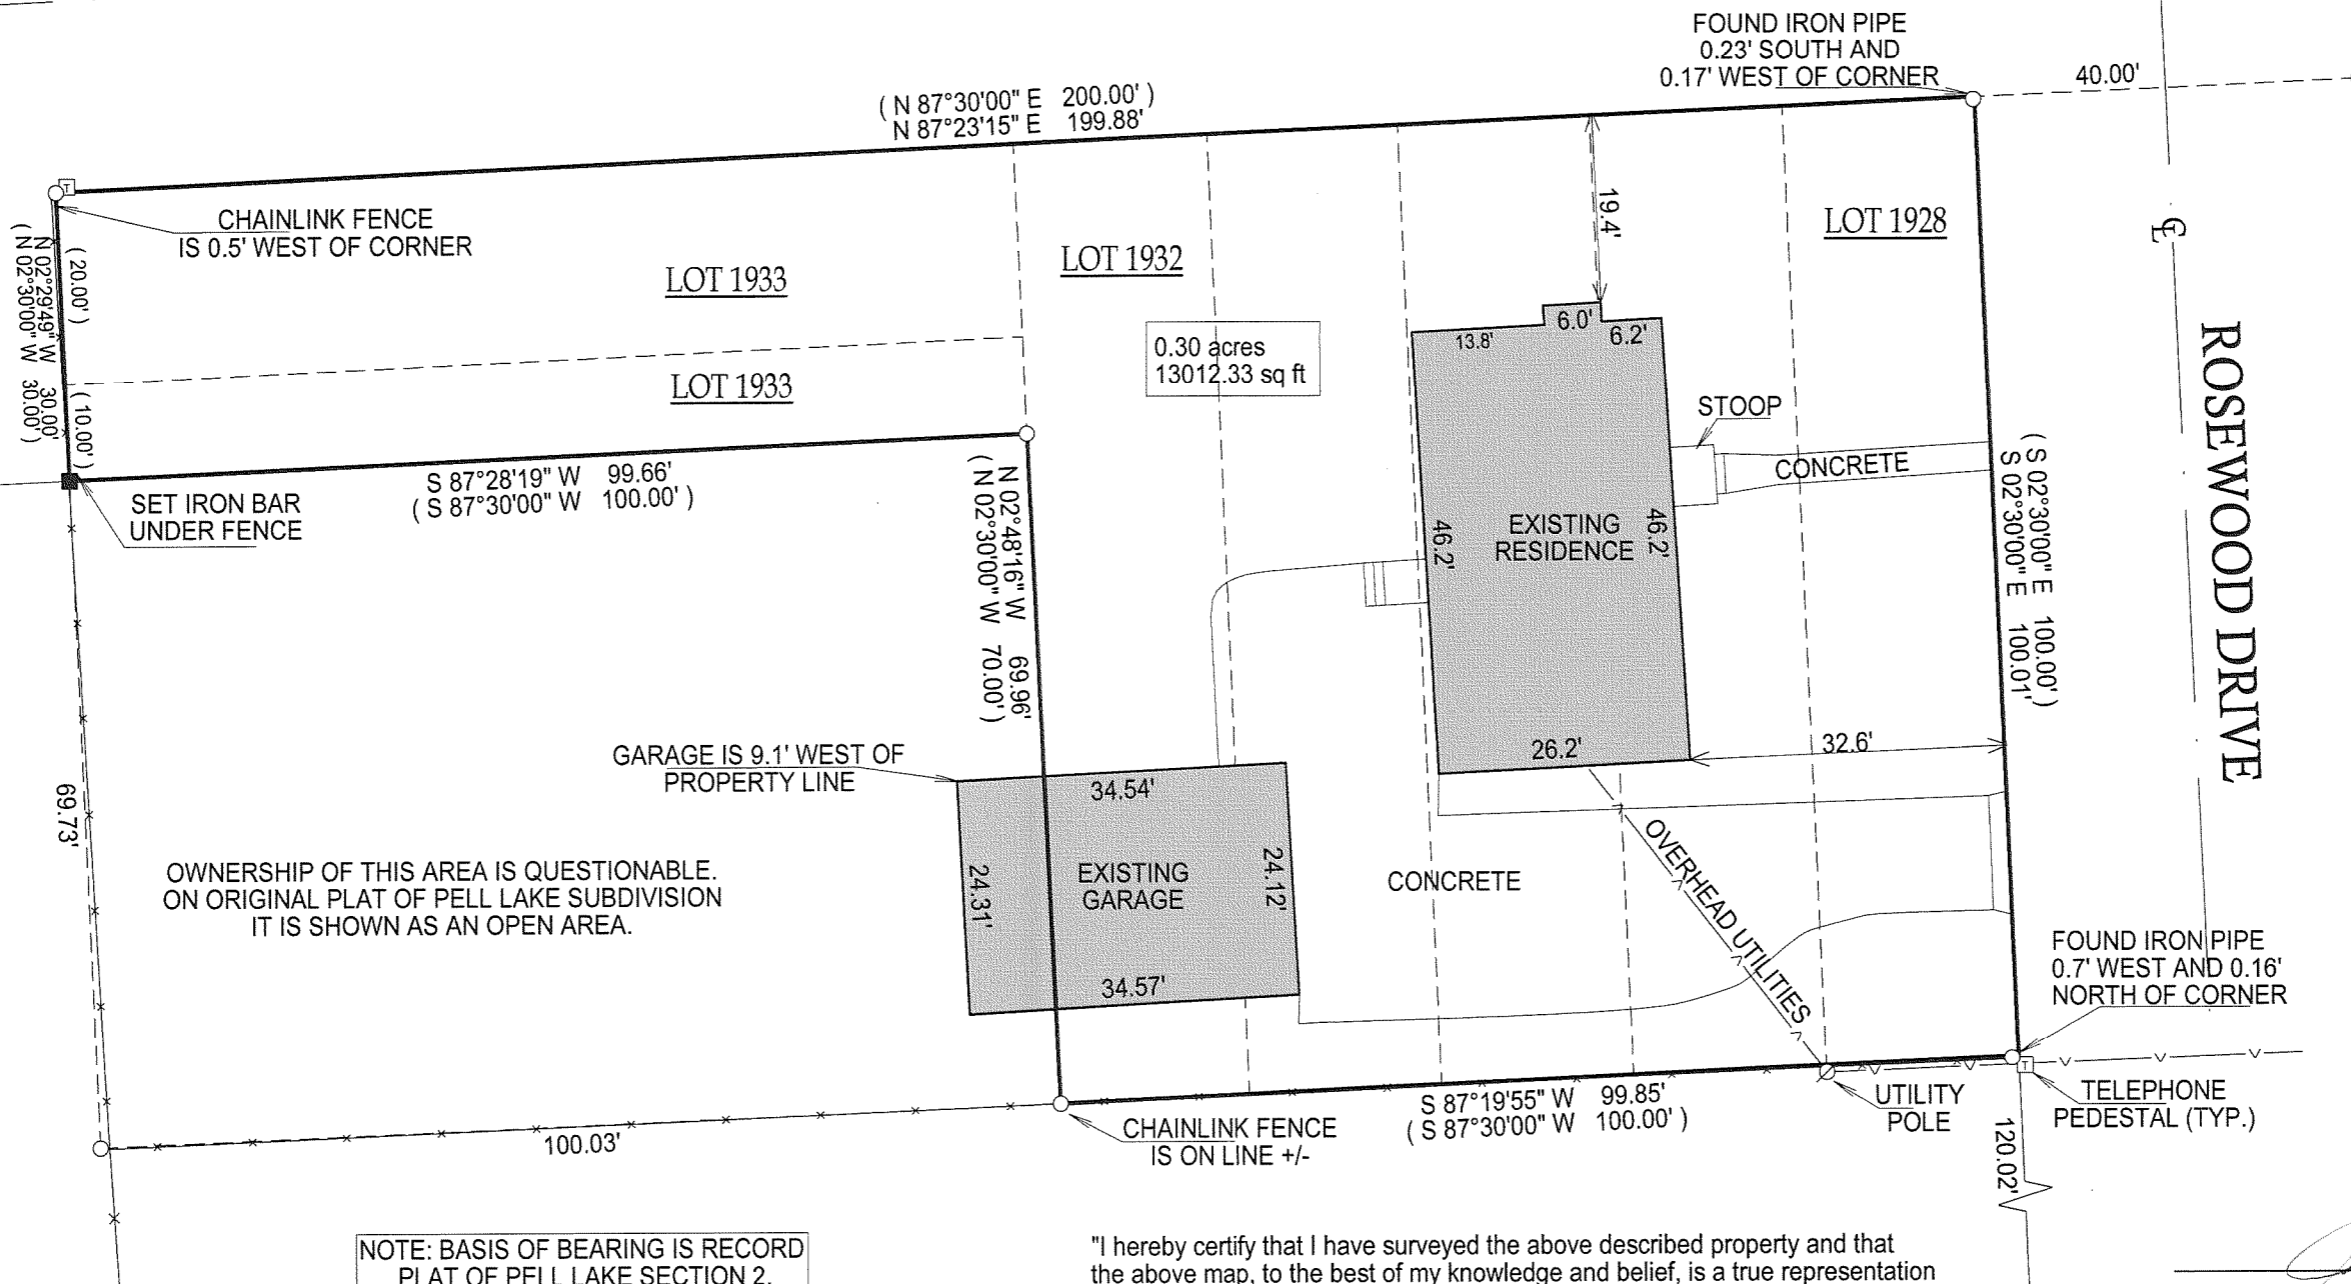

- () = RECORDED AS
- = FOUND IRON BAR
- = FOUND IRON PIPE
- = SET IRON BAR
- = SET IRON PIPE

SCALE: 1" = 20'

JOB #: 09-023

TAX ID #: MPL 00419

NOTE: BASIS OF BEARING IS RECORD
 PLAT OF PELL LAKE SECTION 2.

COMPARE LEGAL DESCRIPTION ABOVE AND DRAWING WITH DEED. FOR BUILDING RESTRICTIONS AND
 EASEMENTS NOT SHOWN, REFER TO DEED, ABSTRACT SOURCES AND LOCAL MUNICIPAL CODES. NOTIFY
 THE SURVEYOR IMMEDIATELY OF ANY DISCREPANCY.

"I hereby certify that I have surveyed the above described property and that
 the above map, to the best of my knowledge and belief, is a true representation
 thereof and shows the size and location of all visible structures, apparent
 easements and encroachments if any."
 This survey is made for the present owners of the property, and those who
 purchase, mortgage, or guarantee the title thereto, within one year from
 the date hereof.



JEFFREY L. KIMPS S - 2436
 Wisconsin Registered Land Surveyor
 (original if signed in red)

DATED THIS 21st, DAY OF APRIL, 2009.

118-2975