

PREPARED FOR:
TOM O'HALLERAN
P.O. BOX 496
PELL LAKE, WI
53157



PLAT OF SURVEY

-OF-


LOTS 307 THRU 311 BLOCK 5, PELL LAKE HIGHLANDS
LOCATED IN SECTION 16, T.1.N., R.18.E, WALWORTH
COUNTY, WISCONSIN.

KROTT SURVEYING INC.

N3705 WILLOW BEND LANE
LAKE GENEVA WI. 53147
PHONE # (262)248-3697
FAX # (262)249-0639

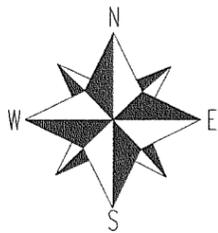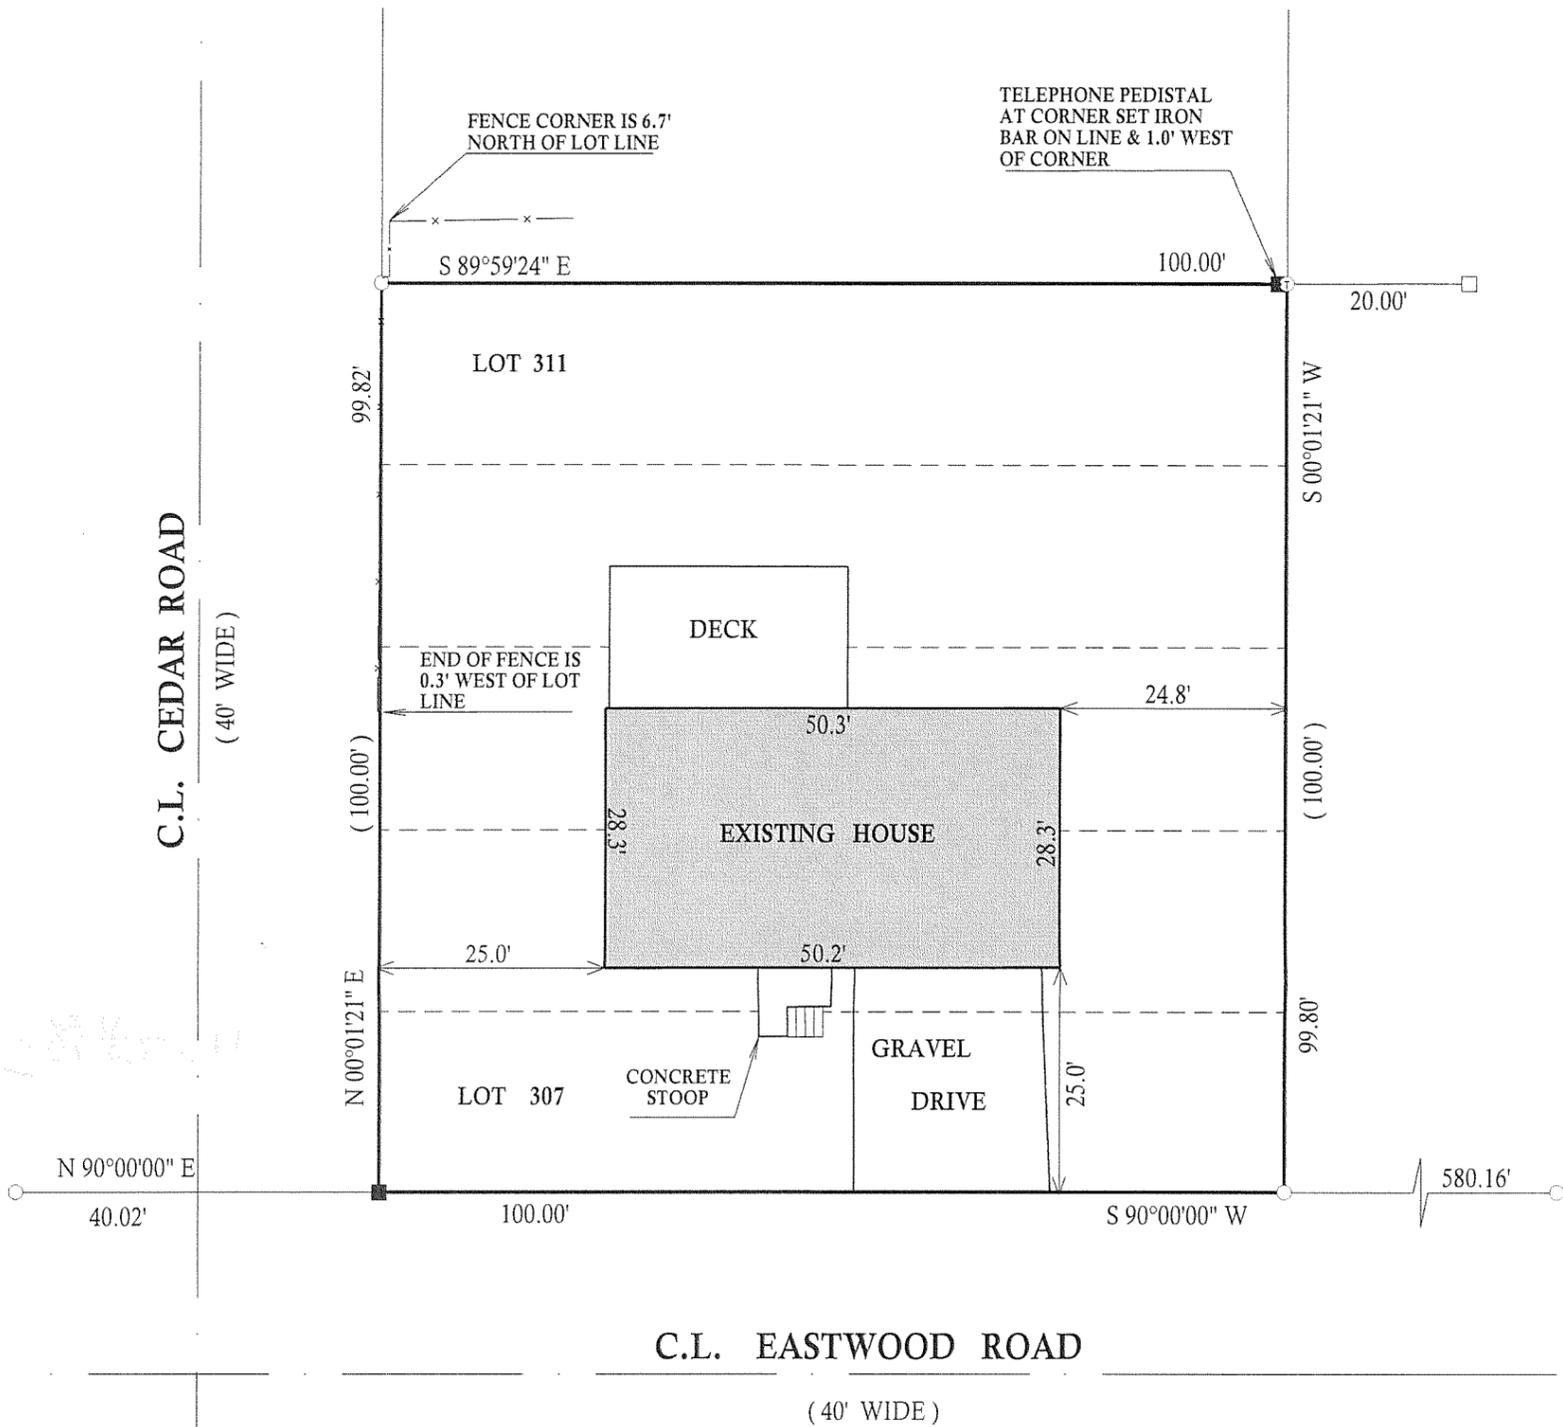

SCALE 1" = 20'

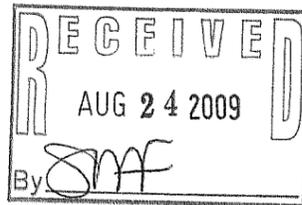

LEGEND

- WOOD FENCE
- FOUND IRON PIPE
- FOUND IRON BAR
- SET IRON BAR
- (XX) RECORDED AS

I have surveyed the above-described property and the above map is a true representation thereof and shows the size and location of the property, its exterior boundaries, the location and dimensions of all structures thereon, fences apparent easements and roadways and visible encroachments, if any.

This survey is made for the exclusive use of the present owners of the property, and also those who purchase, mortgage, or insure the title thereto within one (1) year from date hereof; and as to them I warrant the accuracy of said survey map.



DATED THIS 19th, DAY OF AUGUST, 2009

John P. Krott

JOHN KROTT S - 2258
Wisconsin Registered Land Surveyor
(original if signed in red)

JOB # 09-115

TAX ID # MPLH00067

118-2983