

PREPARED FOR  
 JOHN DANNO  
 W1203 BEECHWOOD DR.  
 GENOA CITY, WI 53128




# PLAT OF SURVEY

-OF-


KROTT SURVEYING INC.

N3705 WILLOW BEND LANE  
 LAKE GENEVA WI. 53147  
 PHONE # (262)248-3697  
 FAX # (262)249-0639

LOTS 8905 - 8910 BLOCK 160, PELL LAKE SUBDIVISION  
 A SUBDIVISION LOCATED IN SECTION 22, TOWN 1 NORTH,  
 RANGE 18 EAST, TOWN OF BLOOMFIELD, WALWORTH  
 COUNTY, WISCONSIN

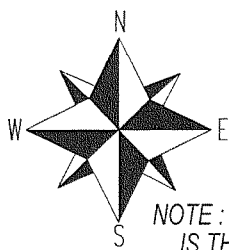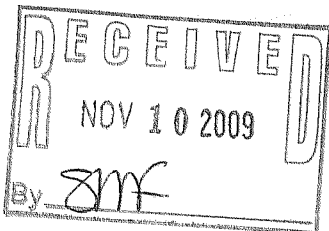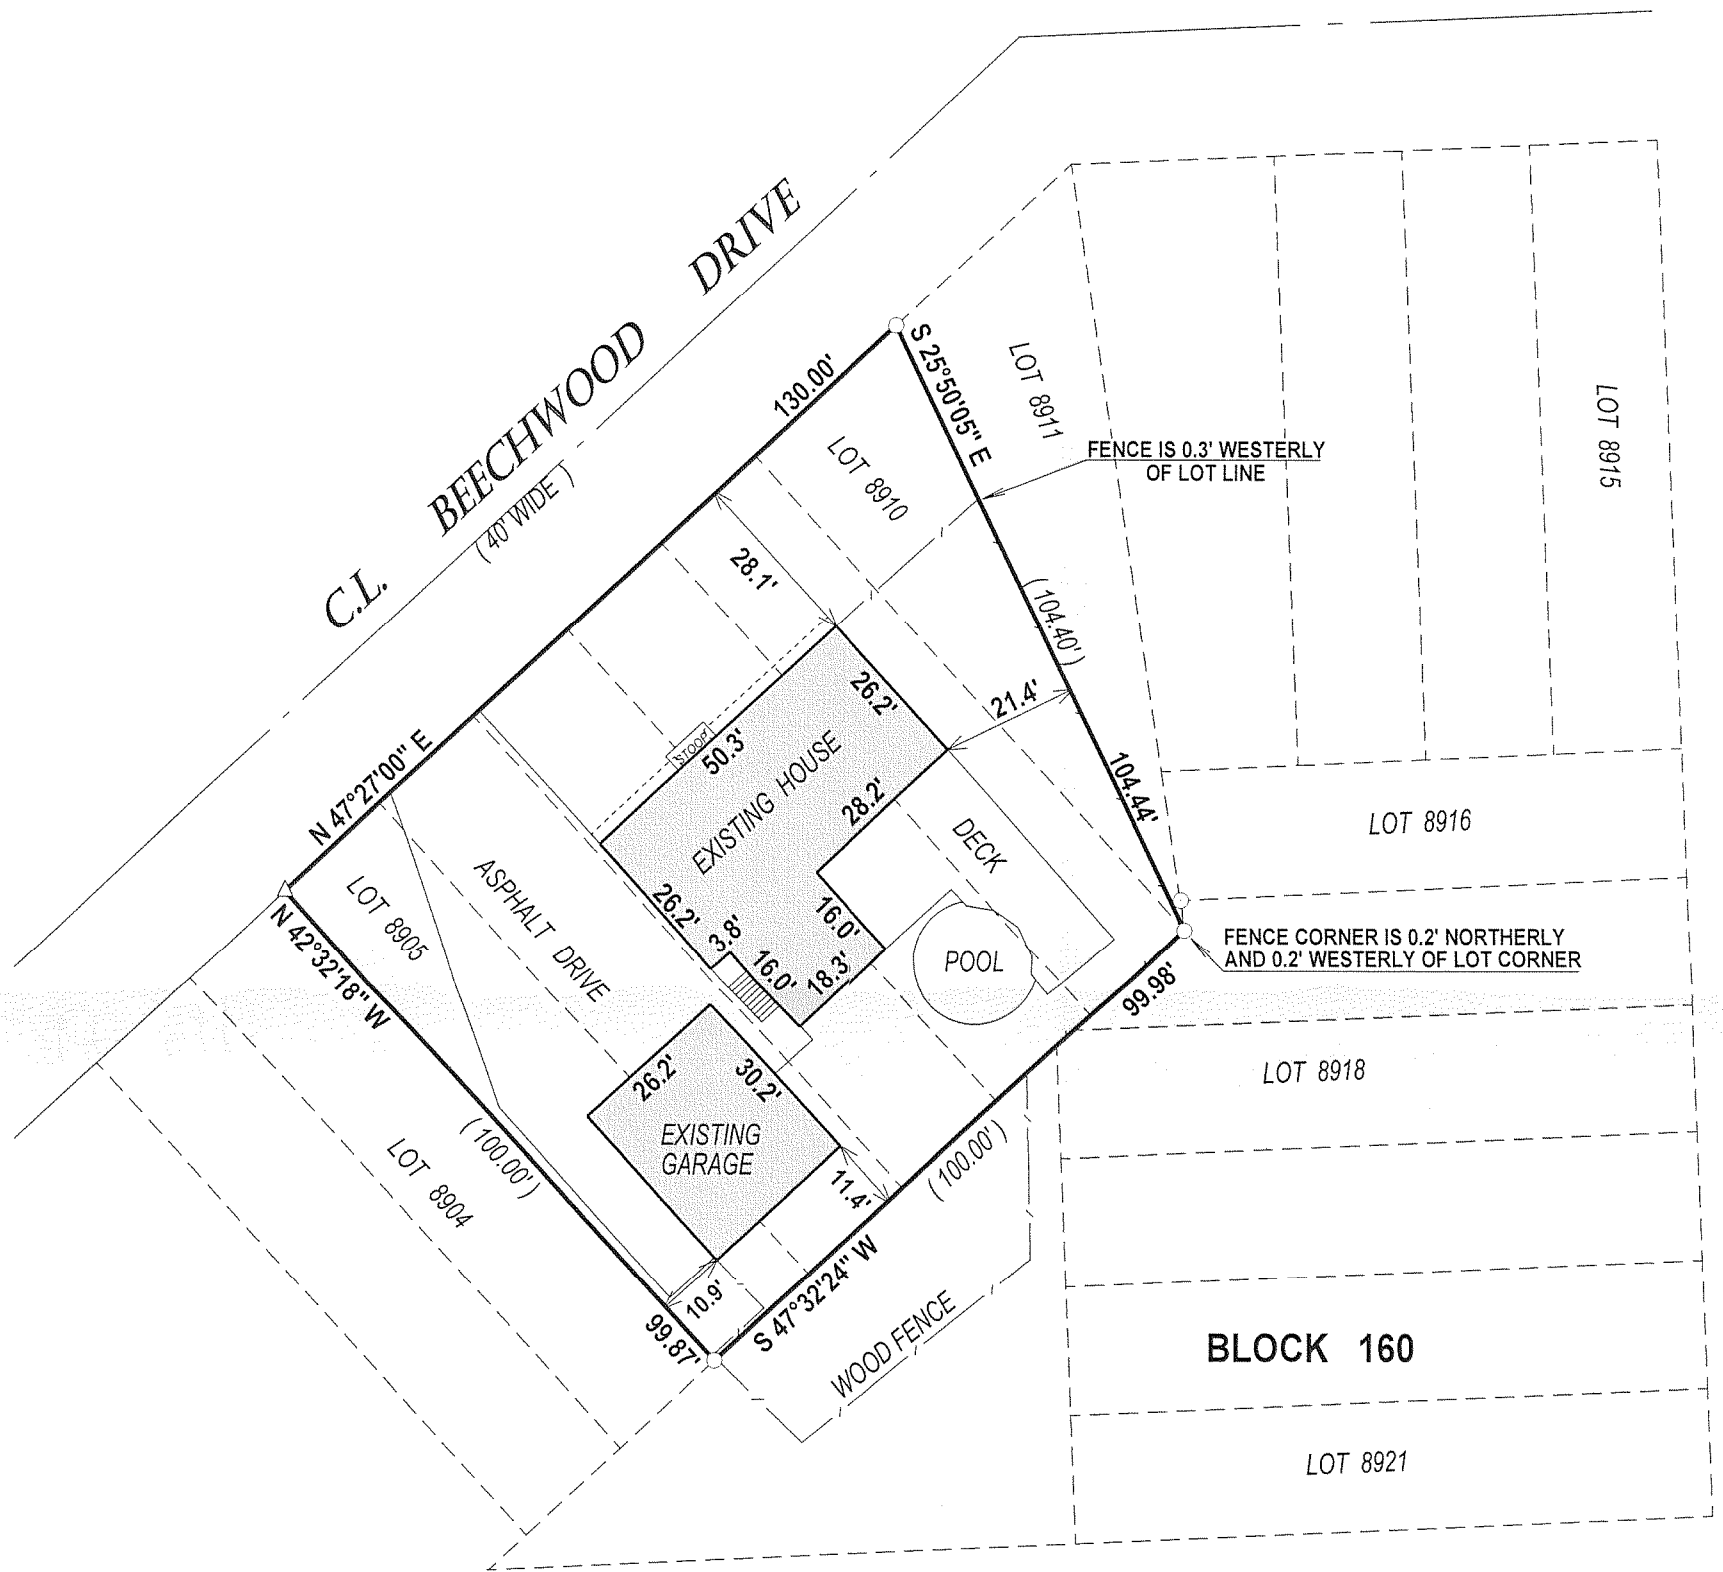

SCALE 1" = 30'  
 0 30 60 90  
 NOTE: BASIS OF BEARING IS THE RECORD PLAT

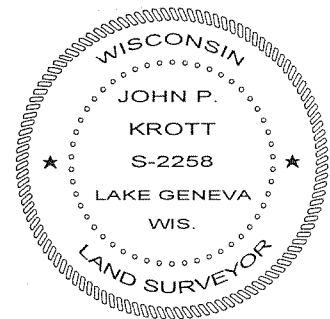

**LEGEND**  
 ○ FOUND IRON PIPE  
 △ FOUND MAG NAIL IN TREE  
 (XX) RECORDED AS  
 TAX ID #: MPL-01790  
 JOB #: 09-142

I have surveyed the above-described property and the above map is a true representation thereof and shows the size and location of the property, its exterior boundaries, the location and dimensions of all structures thereon, fences apparent easements and roadways and visible encroachments, if any.

This survey is made for the exclusive use of the present owners of the property, and also those who purchase, mortgage, or insure the title thereto within one (1) year from date hereof; and as to them I warrant the accuracy of said survey map.

*John P. Krott*

JOHN KROTT S - 2258  
 Wisconsin Registered Land Surveyor  
 (original if signed in red)

DATED THIS 7th DAY OF OCTOBER 2009.

118-2987