
## PLAT OF SURVEY -OF-

LOT 16, WM. ELLIOTTS POWERS LAKE SUBDIVISION, LOCATED IN THE NORTHEAST FRACTIONAL 1/4 OF SECTION 13, TOWNSHIP 1 NORTH, RANGE 18 EAST OF THE TOWN OF BLOOMFIELD, WALWORTH COUNTY, WISCONSIN.

SURVEY FOR: ERICA MCKOANE

SURVEY LOCATION: W187 LAKE STREET



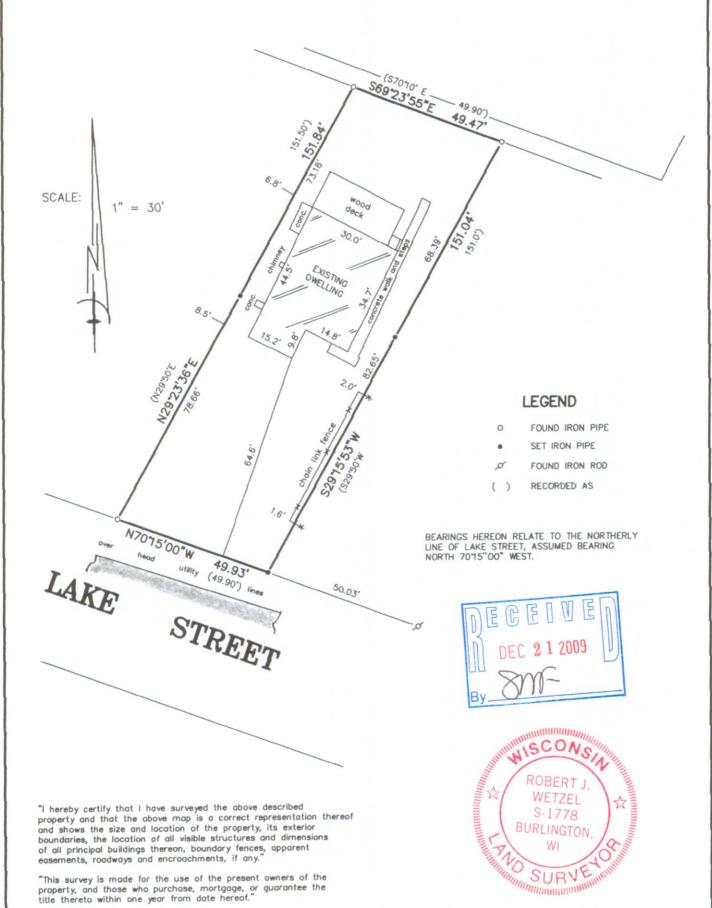

B.W. SURVEYING, INC.

412 N. PINE STREET BURLINGTON, WI 53105 (262)-767-0225 THIS IS NOT AN ORIGINAL PRINT UNLESS THIS SEAL IS RED.

ROBERT J. WETZEL S-1778

AUGUST 13, 2009
DATE

JOB NUMBER

ME - 16

118-3992