
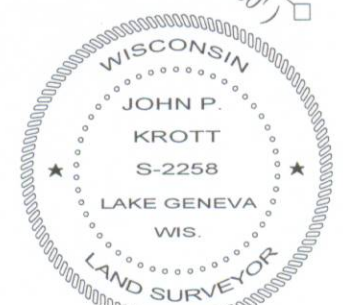
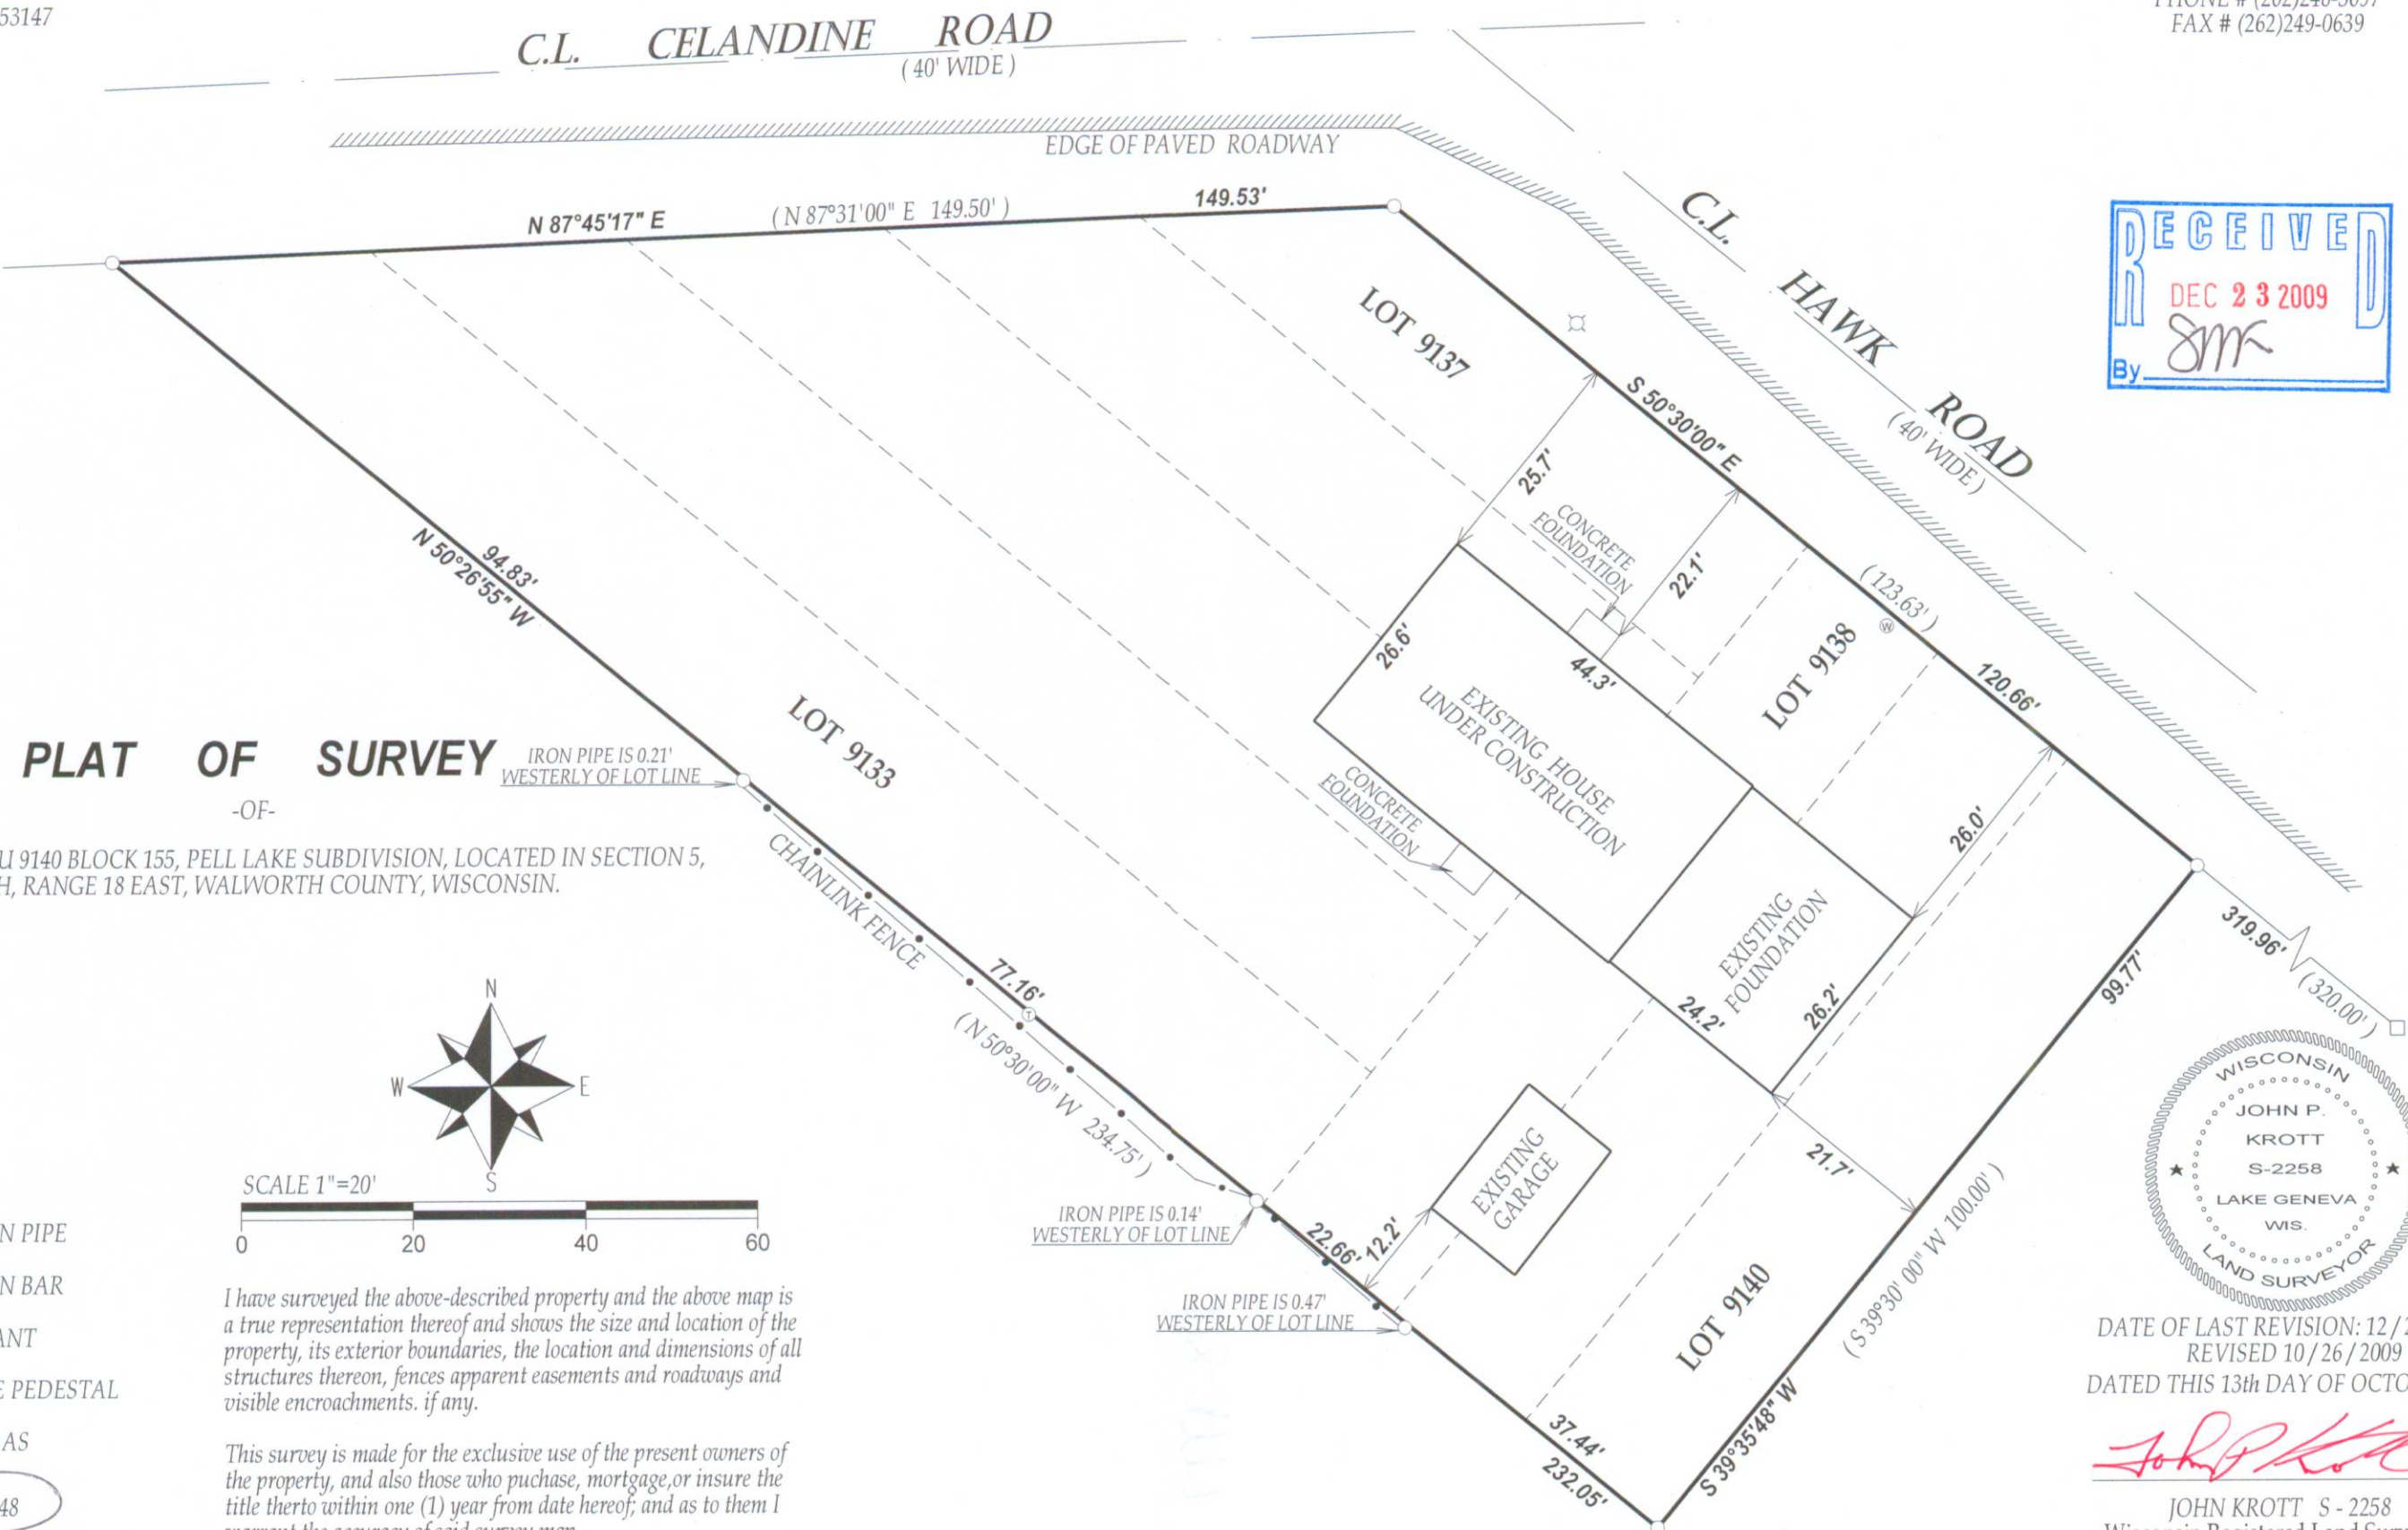


PREPARED FOR
GREEN STONE BUILDERS
C/O DAN PETHER
PO. BOX 1315
LAKE GENEVA WI. 53147

KROTT SURVEYING INC.
N3705 WILLOW BEND LANE
LAKE GENEVA WI. 53147
PHONE # (262)248-3697
FAX # (262)249-0639

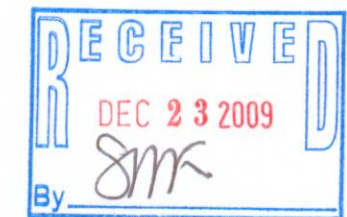

DATE OF LAST REVISION: 12/21/2009.
REVISED 10/26/2009
DATED THIS 13th DAY OF OCTOBER 2009.

John P. Krott
JOHN KROTT S - 2258
Wisconsin Registered Land Surveyor
(original if signed in red)

118-2997