


PREPARED FOR
BECKY MERIVIN
THE RAULAND AGENCY, INC.
PO. BOX 159
WALWORTH WI. 53184


PLAT OF SURVEY

-OF-
LOTS 231 THRU 225 BLOCK 4, PELL LAKE HIGHLANDS
SUBDIVISION, LOCATED IN SECTION 16, TOWN 1 NORTH,
RANGE 18 EAST, WALWORTH COUNTY, WISCONSIN.

KROTT SURVEYING INC.
N3705 WILLOW BEND LANE
LAKE GENEVA WI. 53147
PHONE # (262)248-3697
FAX # (262)249-0639

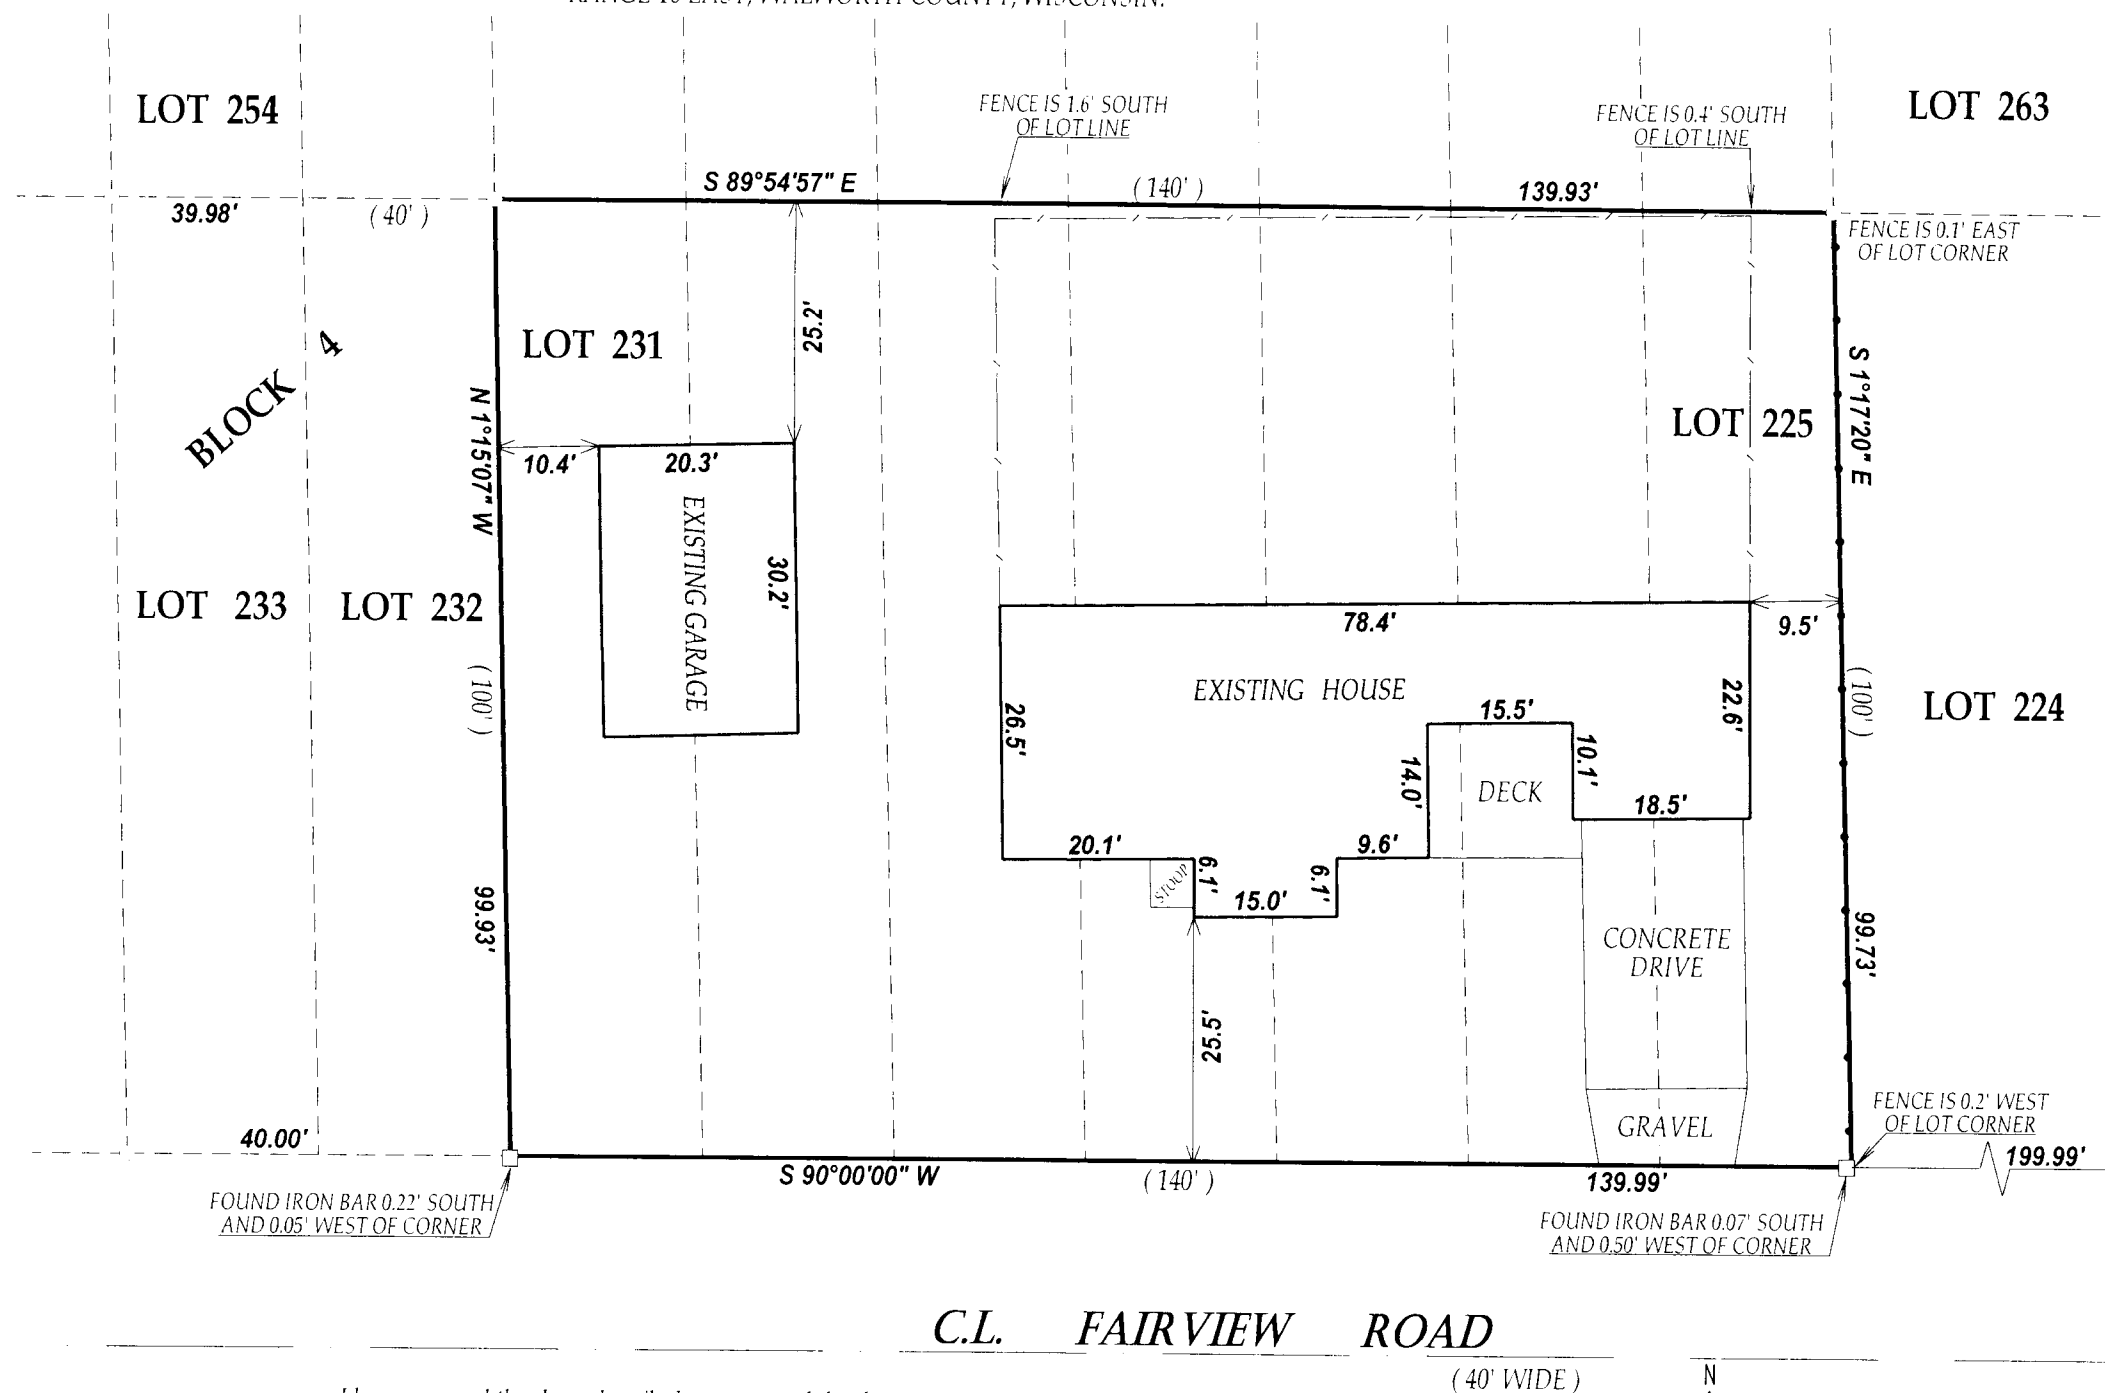


RECEIVED
DEC 03 2010
By *SMK*

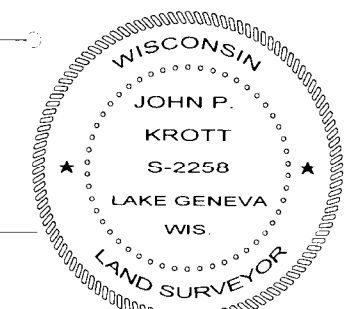

DATED THIS 30th DAY OF NOVEMBER 2010.

John P. Krott

JOHN KROTT S - 2258
Wisconsin Registered Land Surveyor
(original if signed in red)

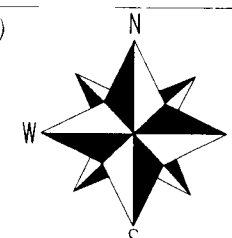

SCALE 1"=20'



NOTE: FAIRVIEW ROAD WAS ASSUMED TO BEAR S 90°00'00" W

118-20113