

104014
104014S1.DWG


100 SOUTH SECOND STREET
WATERFORD, WISCONSIN 53185

LOTS 6719 THRU 6723, BLOCK 145, PELL LAKE SUBDIVISION SECTION 4, LOCATED IN THE NORTH 1/2 OF SECTION 15, TOWN 1 NORTH, RANGE 18 EAST, TOWN OF BLOOMFIELD, WALWORTH COUNTY, WISCONSIN.

SURVEY PREPARED FOR: LARISSA DIDRIKSEN
W1113 MIGNONETTE ROAD
GENOA CITY, WI 53128



● - FOUND IRON PIPE
 ○ - SET IRON PIPE
 x-x-x - FENCE
 { } - RECORDED AS
 E861.2 - EXISTING SPOT ELEVATION, BASED
 ON MEAN SEA LEVEL DATUM

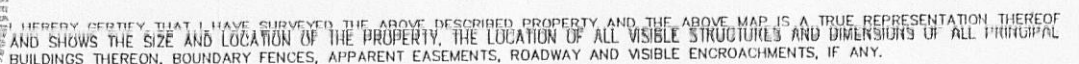

RECERTIFIED.

RECEIVED
JUN 23 2011
By *SMF*

MPL - 14/660

118-2069