




PREPARED FOR  
MAT BESLER  
544 ELM ST.  
GLEN ELLYN IL 60137

**KROTT SURVEYING INC.**  
N3705 WILLOW BEND LANE  
LAKE GENEVA WI. 53147  
PHONE # (262)248-3697  
FAX # (262)249-0639

# PLAT OF SURVEY

-OF-


LOTS 5135 THRU 5141 BLOCK 97 OF PELL LAKE SUBDIVISION,  
LOCATED IN TOWN 1 NORTH, RANGE 18 EAST, WALWORTH  
COUNTY, WISCONSIN.

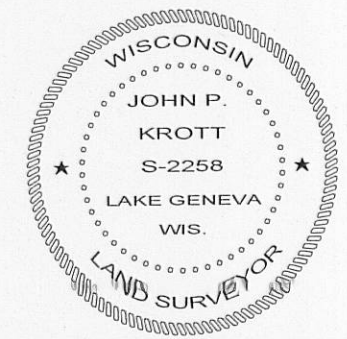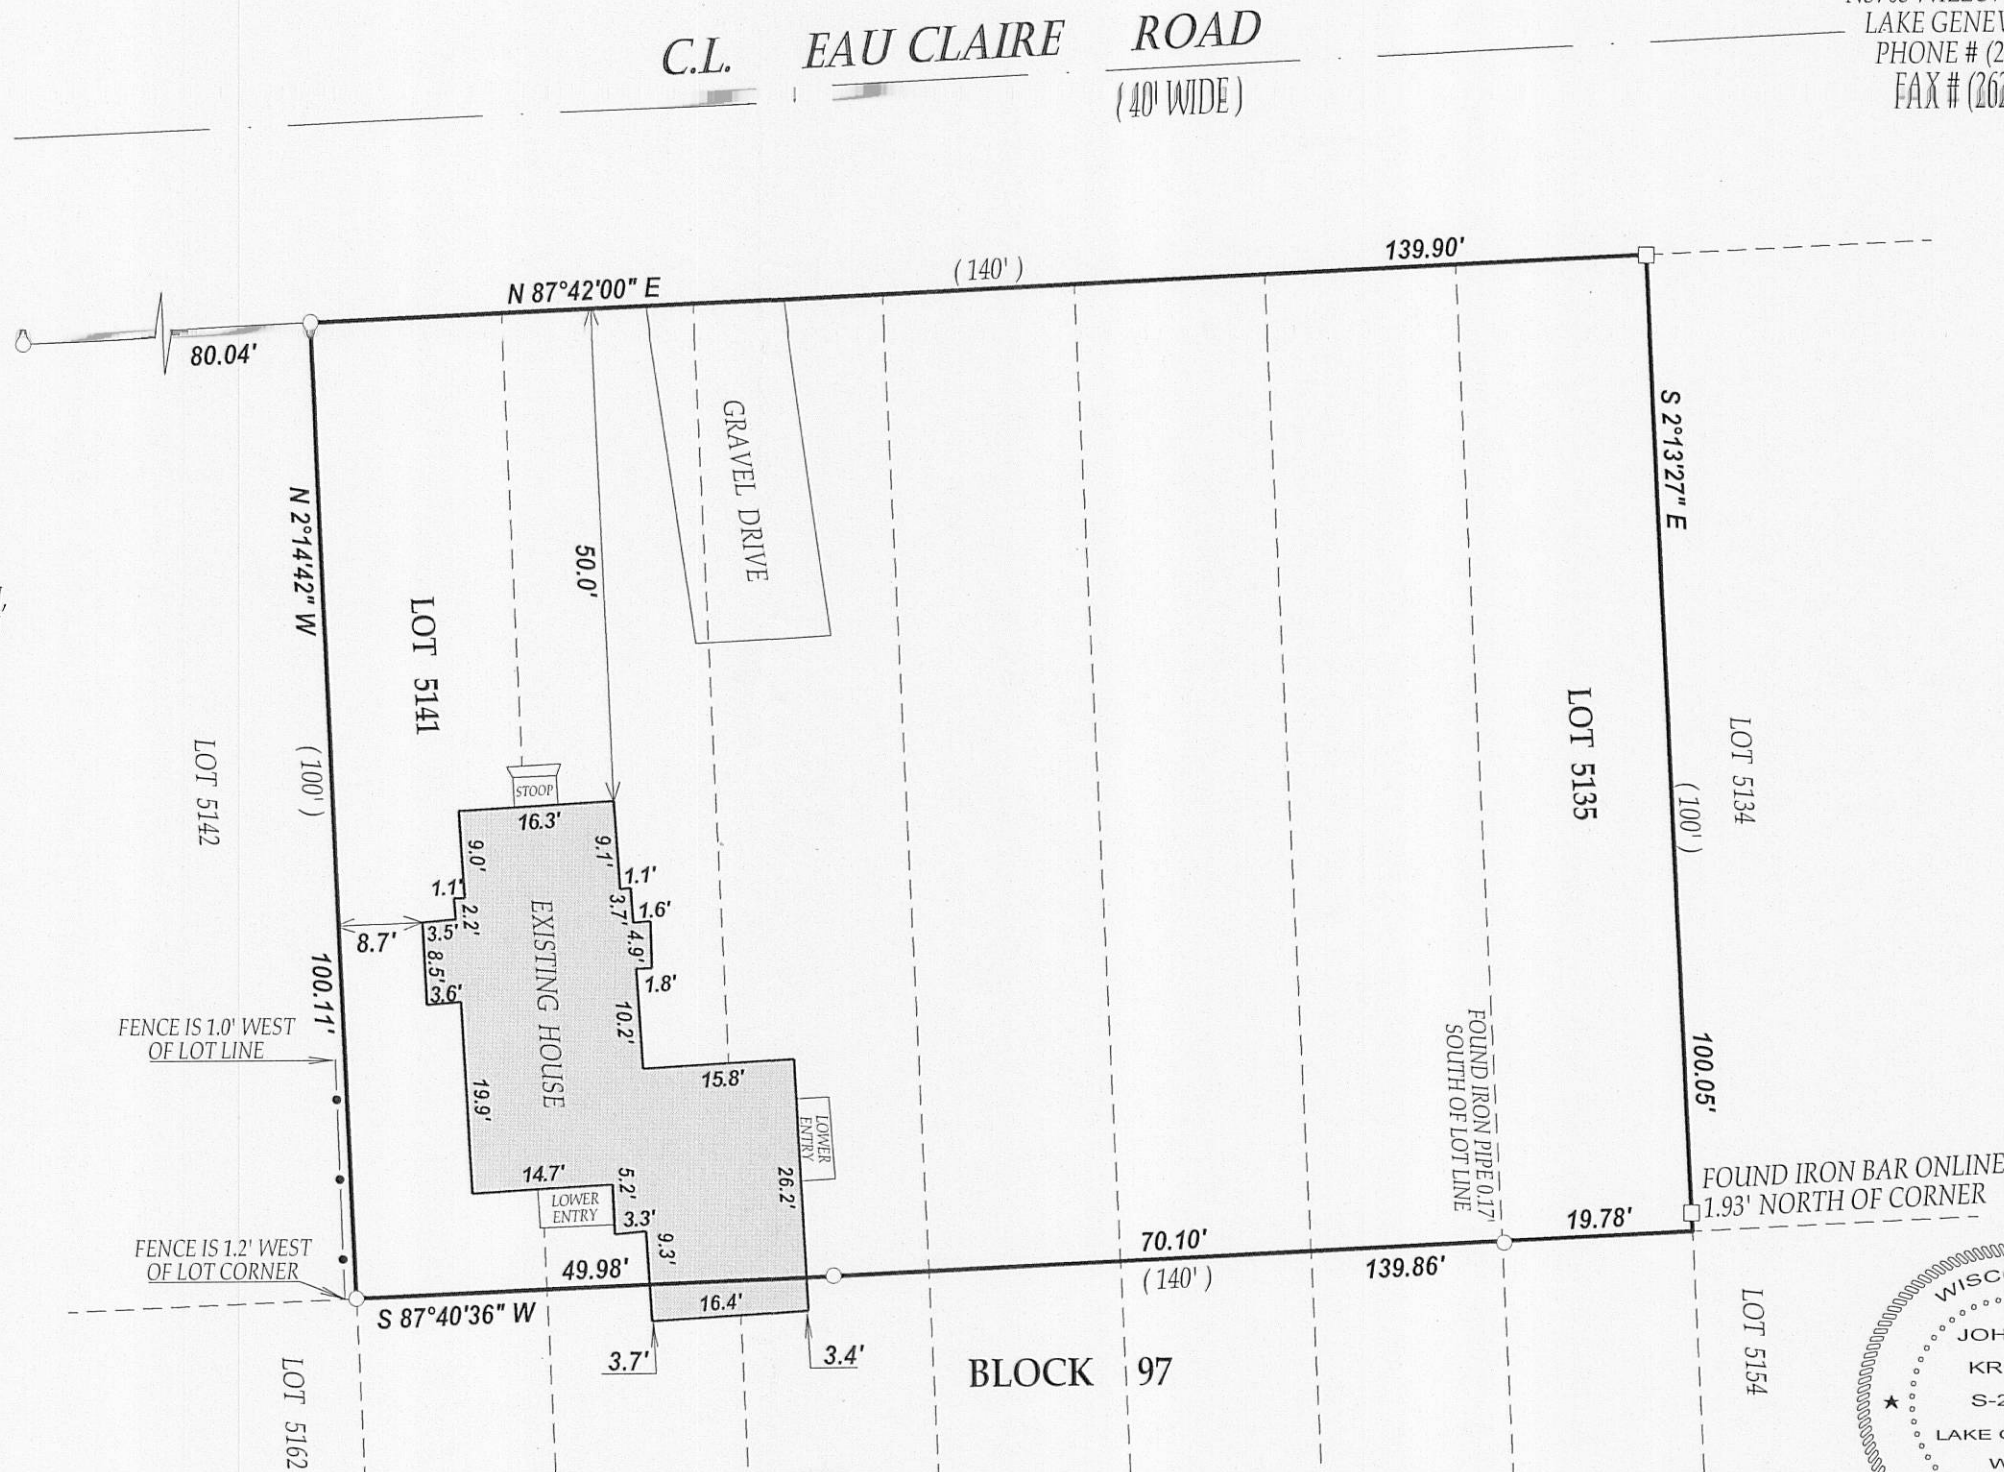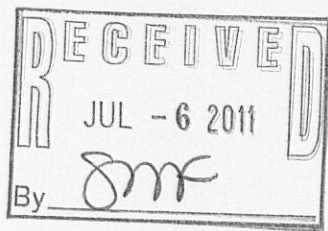


DATED THIS 27th DAY OF APRIL 2011.

*John P. Krott*

JOHN KROTT S - 2258  
Wisconsin Registered Land Surveyor  
(original if signed in red)

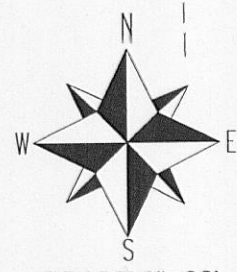

SCALE 1"=20'

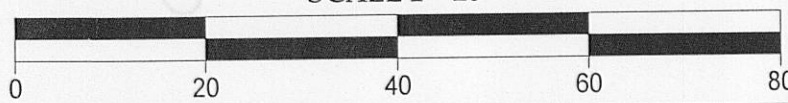

I have surveyed the above-described property and the above map is a true representation thereof and shows the size and location of the property, its exterior boundaries, the location and dimensions of all structures thereon, fences apparent easements and roadways and visible encroachments, if any.

This survey is made for the exclusive use of the present owners of the property, and also those who purchase, mortgage, or insure the title thereto within one (1) year from date hereof, and as to them I warrant the accuracy of said survey map.

NOTE: BEARINGS ARE REFERENCED TO THE RECORD PLAT

- LEGEND**
- FOUND IRON PIPE
  - FOUND IRON BAR
- (XX) RECORDED AS  
TAX ID # MPL01104  
JOB # 11-056

MPL-1104

118-3073