

DEGEN - FOAT SURVEYING, INC.

115057  
115057S1.DWG

100 SOUTH SECOND STREET  
WATERFORD, WISCONSIN 53185  
(262)534-5404 (FAX)534-2022

PLAT OF SURVEY

LOTS 1178-1182, BLOCK 26 OF SECTION 1 OF PELL LAKE SUBDIVISION, A SUBDIVISION LOCATED IN SECTION 22, TOWN 1 NORTH, RANGE 18 EAST, TOWN OF BLOOMFIELD, WALWORTH COUNTY, WISCONSIN.

\* REFER TO A CURRENT TITLE REPORT FOR EASEMENTS, RESTRICTIONS OR COVENANTS OF RECORD THAT MAY AFFECT THIS LAND. \*


SURVEY PREPARED FOR: ADVANTAGE TITLE & CLOSING SERVICES, INC.  
P.O. BOX 217  
320 E. MAIN STREET  
TWIN LAKES, WI 53181



SCALE: 1" = 30'  
BEARING BASE: AS RECORDED AS.

LEGEND

- - FOUND IRON PIPE
- ( ) - RECORDED AS

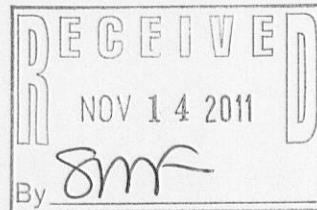

I HEREBY CERTIFY THAT I HAVE SURVEYED THE ABOVE DESCRIBED PROPERTY AND THE ABOVE MAP IS A TRUE REPRESENTATION THEREOF AND SHOWS THE SIZE AND LOCATION OF THE PROPERTY, THE LOCATION OF ALL VISIBLE STRUCTURES AND DIMENSIONS OF ALL PRINCIPAL BUILDINGS THEREON, BOUNDARY FENCES, APPARENT EASEMENTS, ROADWAY AND VISIBLE ENCROACHMENTS, IF ANY.

THIS SURVEY IS MADE FOR THE PRESENT OWNERS OF THE PROPERTY, AND ALSO THOSE WHO PURCHASE, OR GUARANTEE THE TITLE THERETO WITHIN (1) YEAR FROM THE DATE HEREOF.

DATED AT WATERFORD, WI THIS 13TH DAY OF JULY 2011

RECERTIFIED \_\_\_\_\_

*Gary B. Foat*

MPL-261

118-3087