

PREPARED FOR
RICH STRATTON
PO. BOX 442
MCHENERY IL. 60051




PLAT OF SURVEY

- OF -


KROTT SURVEYING INC.

N3705 WILLOW BEND LANE
LAKE GENEVA WI. 53147
PHONE # (262)248-3697
FAX # (262)249-0639

LOTS 2960-2963 BLOCK 52 PELL LAKE SUBDIVISION,
A SUBDIVISION LOCATED IN SECTION 22, TOWN 1 NORTH,
RANGE 18 EAST, TOWN OF BLOOMFIELD, WALWORTH
COUNTY, WISCONSIN

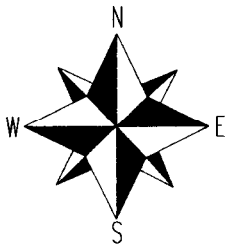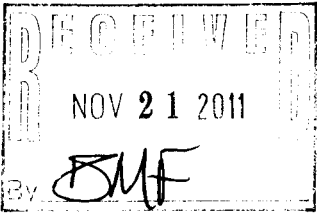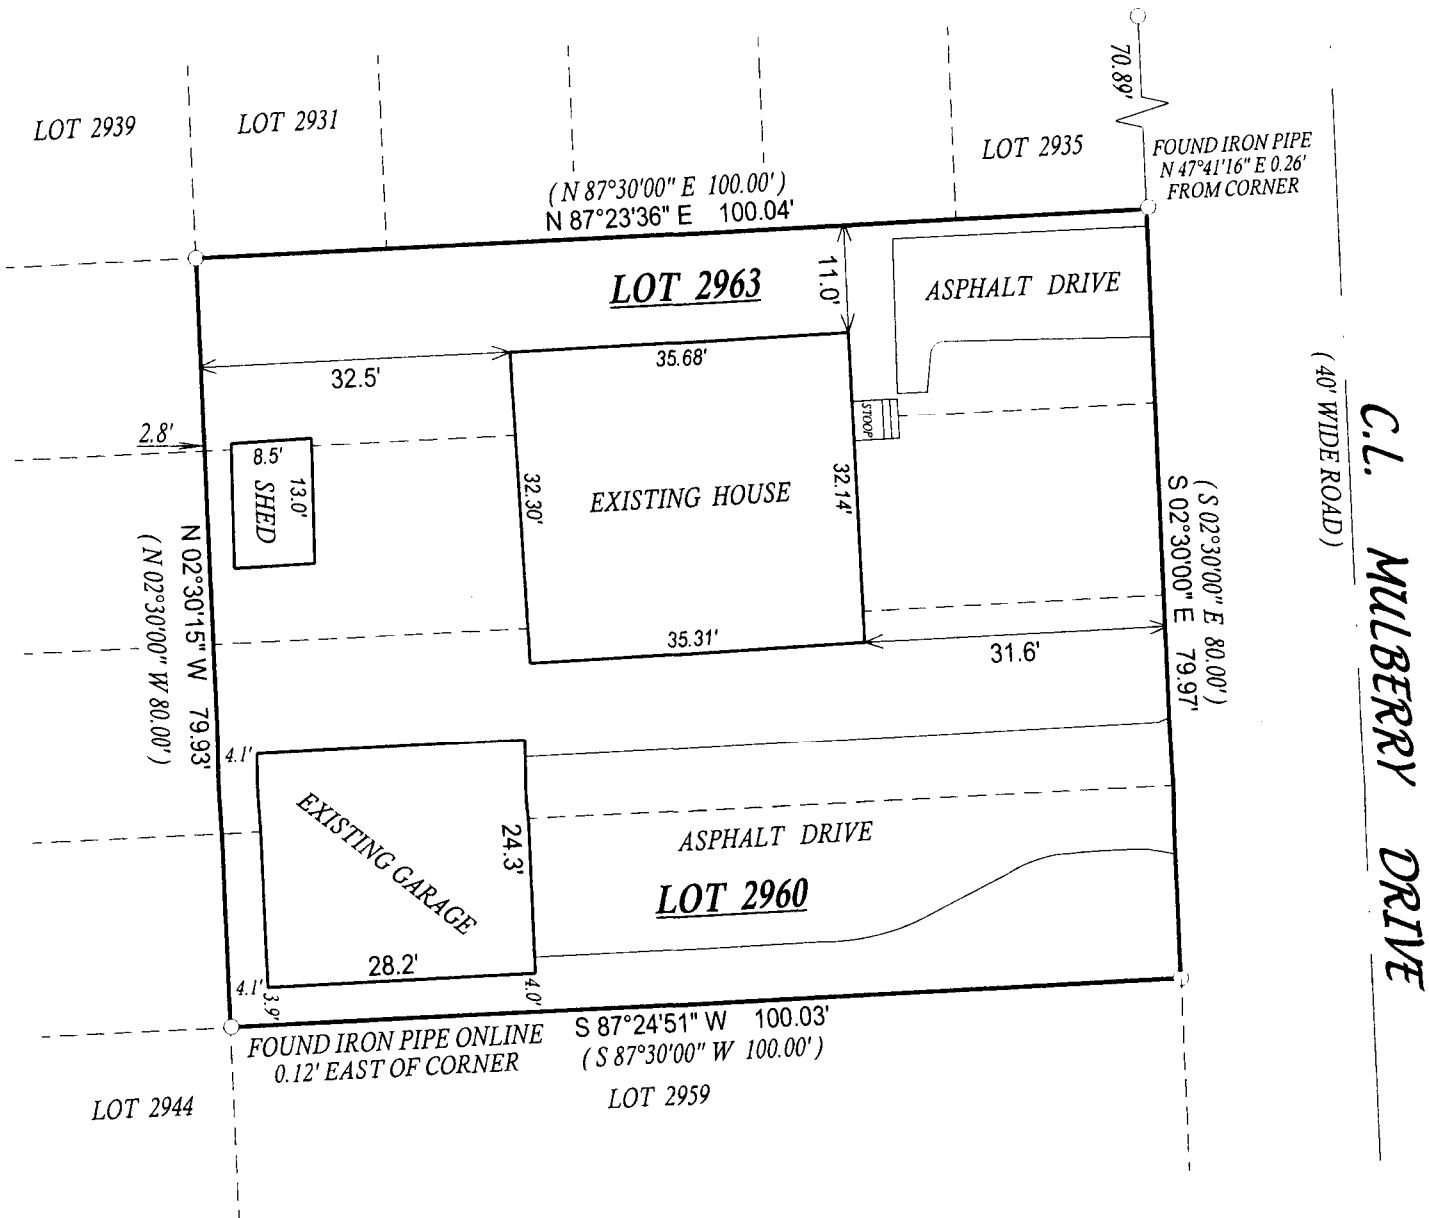

SCALE 1" = 20'

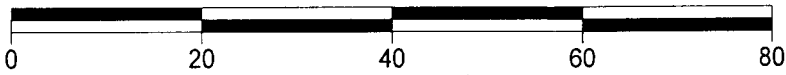

NOTE : NEARINGS ARE REFERENCED TO THE RECORD PLAT.

LEGEND

○ FOUND IRON PIPE


(XX) RECORDED AS

TAXID # MPL00620

JOB # 05-208

I have surveyed the above-described property and the above map is a true representation thereof and shows the size and location of the property, its exterior boundaries, the location and dimensions of all structures thereon, fences apparent easements and roadways and visible encroachments, if any.

This survey is made for the exclusive use of the present owners of the property, and also those who purchase, mortgage, or insure the title thereto within one (1) year from date hereof; and as to them I warrant the accuracy of said survey map.

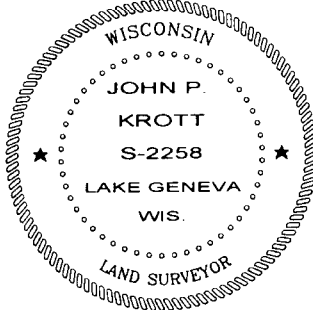

DATED THIS THE 11th DAY OF OCTOBER 2011.

John P. Krott

JOHN KROTT S - 2258
Wisconsin Registered Land Surveyor
(original if signed in red)

118 - 3093