

WORK ORDERED BY:
LOWELL MANAGEMENT
PO BOX 926
LAKE GENEVA, WI. 53147

FARRIS, HANSEN & ASSOCIATES, INC.
ENGINEERING - ARCHITECTURE - SURVEYING
7 RIDGEWAY COURT P.O. BOX 437
ELKHORN, WISCONSIN 53121
OFFICE: (262) 723-2098 FAX: (262) 723-5866



REVISIONS

PROJECT NO.
8520
DATE
02-22-2012
SHEET NO.
1 OF 1

PLAT OF SURVEY

LOT 14 TUSCANY OF LAKE GENEVA A SUBDIVISION

LOCATED IN THE NW 1/4 OF THE NW 1/4, & THE NE 1/4 OF THE NW 1/4,
THE SW 1/4 OF THE NW 1/4, & THE SE 1/4 OF THE NW 1/4
SECTION 3, TOWN 1 NORTH, RANGE 18 EAST
WALWORTH COUNTY, WISCONSIN

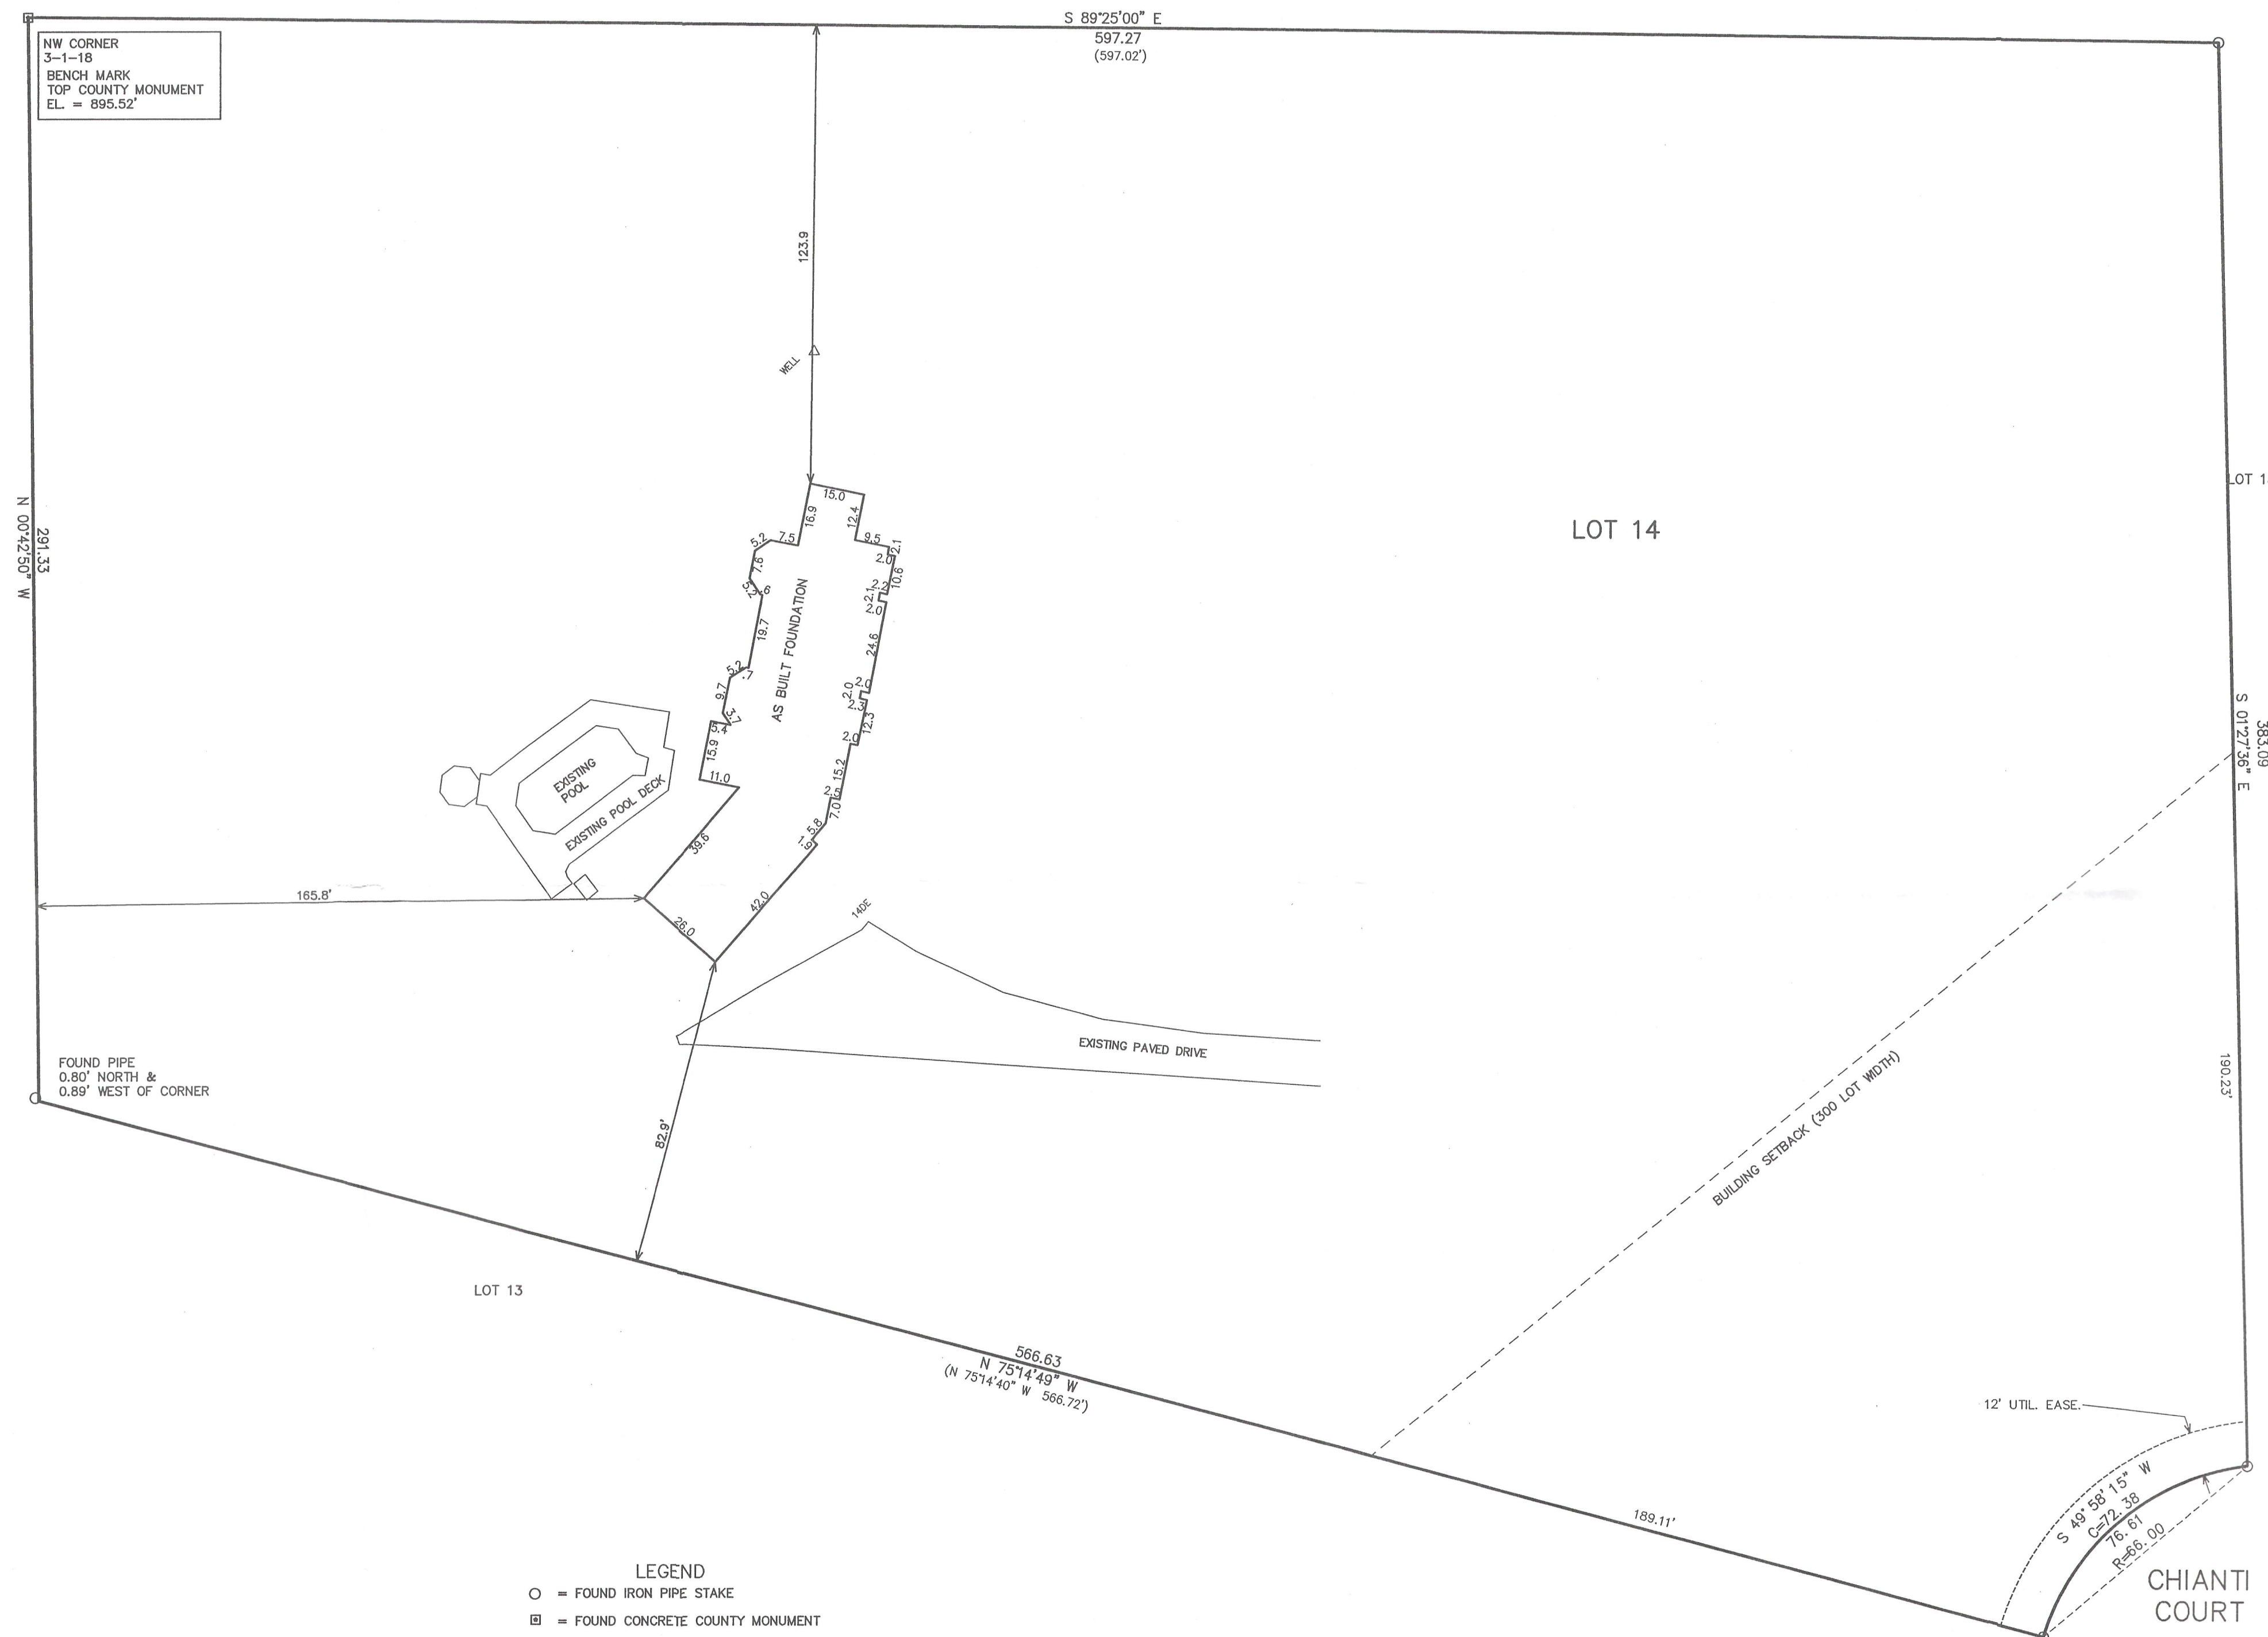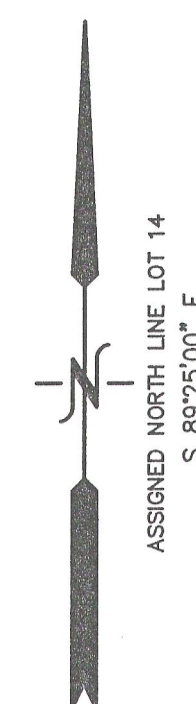


MAP SCALE IN FEET ORIGINAL 1" = 30'



DATED: 3-15-2012
PETER S. GORDON R.L.S. 2101

REVISED 05-01-2012
TO SHOW SIZE & LOCATION OF
AS BUILT FOUNDATION

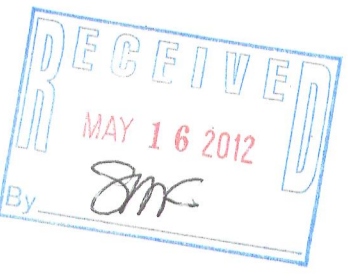

5/7/2012 X:\Projects\8520\Drawings\PLAT

MTU - 14

118-3113