

PREPARED FOR  
 DEBBIE COBIAN  
 KEEFE REAL ESTATE  
 751 GENEVA PARKWAY  
 LAKE GENEVA WI. 53147



# PLAT OF SURVEY

-OF-

LOTS 8851 THRU 8857 BLOCK 161 AS DESIGNATED AND DELINEATED  
 ON THE MAP ENTITLED MAP OF SECTION FIVE OF PELL LAKE SUBDIVISION  
 WALWORTH COUNTY, WISCONSIN.

KROTT SURVEYING INC.

N3705 WILLOW BEND LANE  
 LAKE GENEVA WI. 53147  
 PHONE # (262)248-3697  
 FAX # (262)249-0639

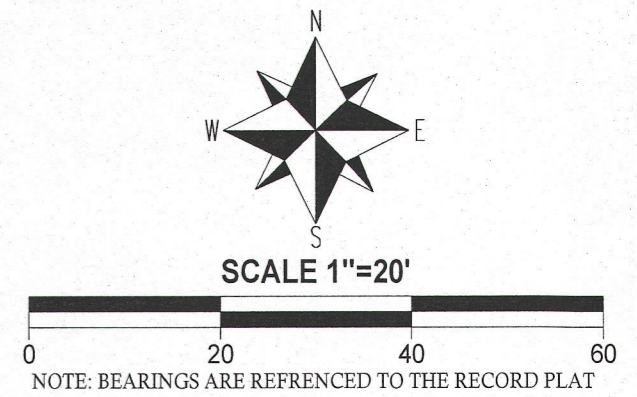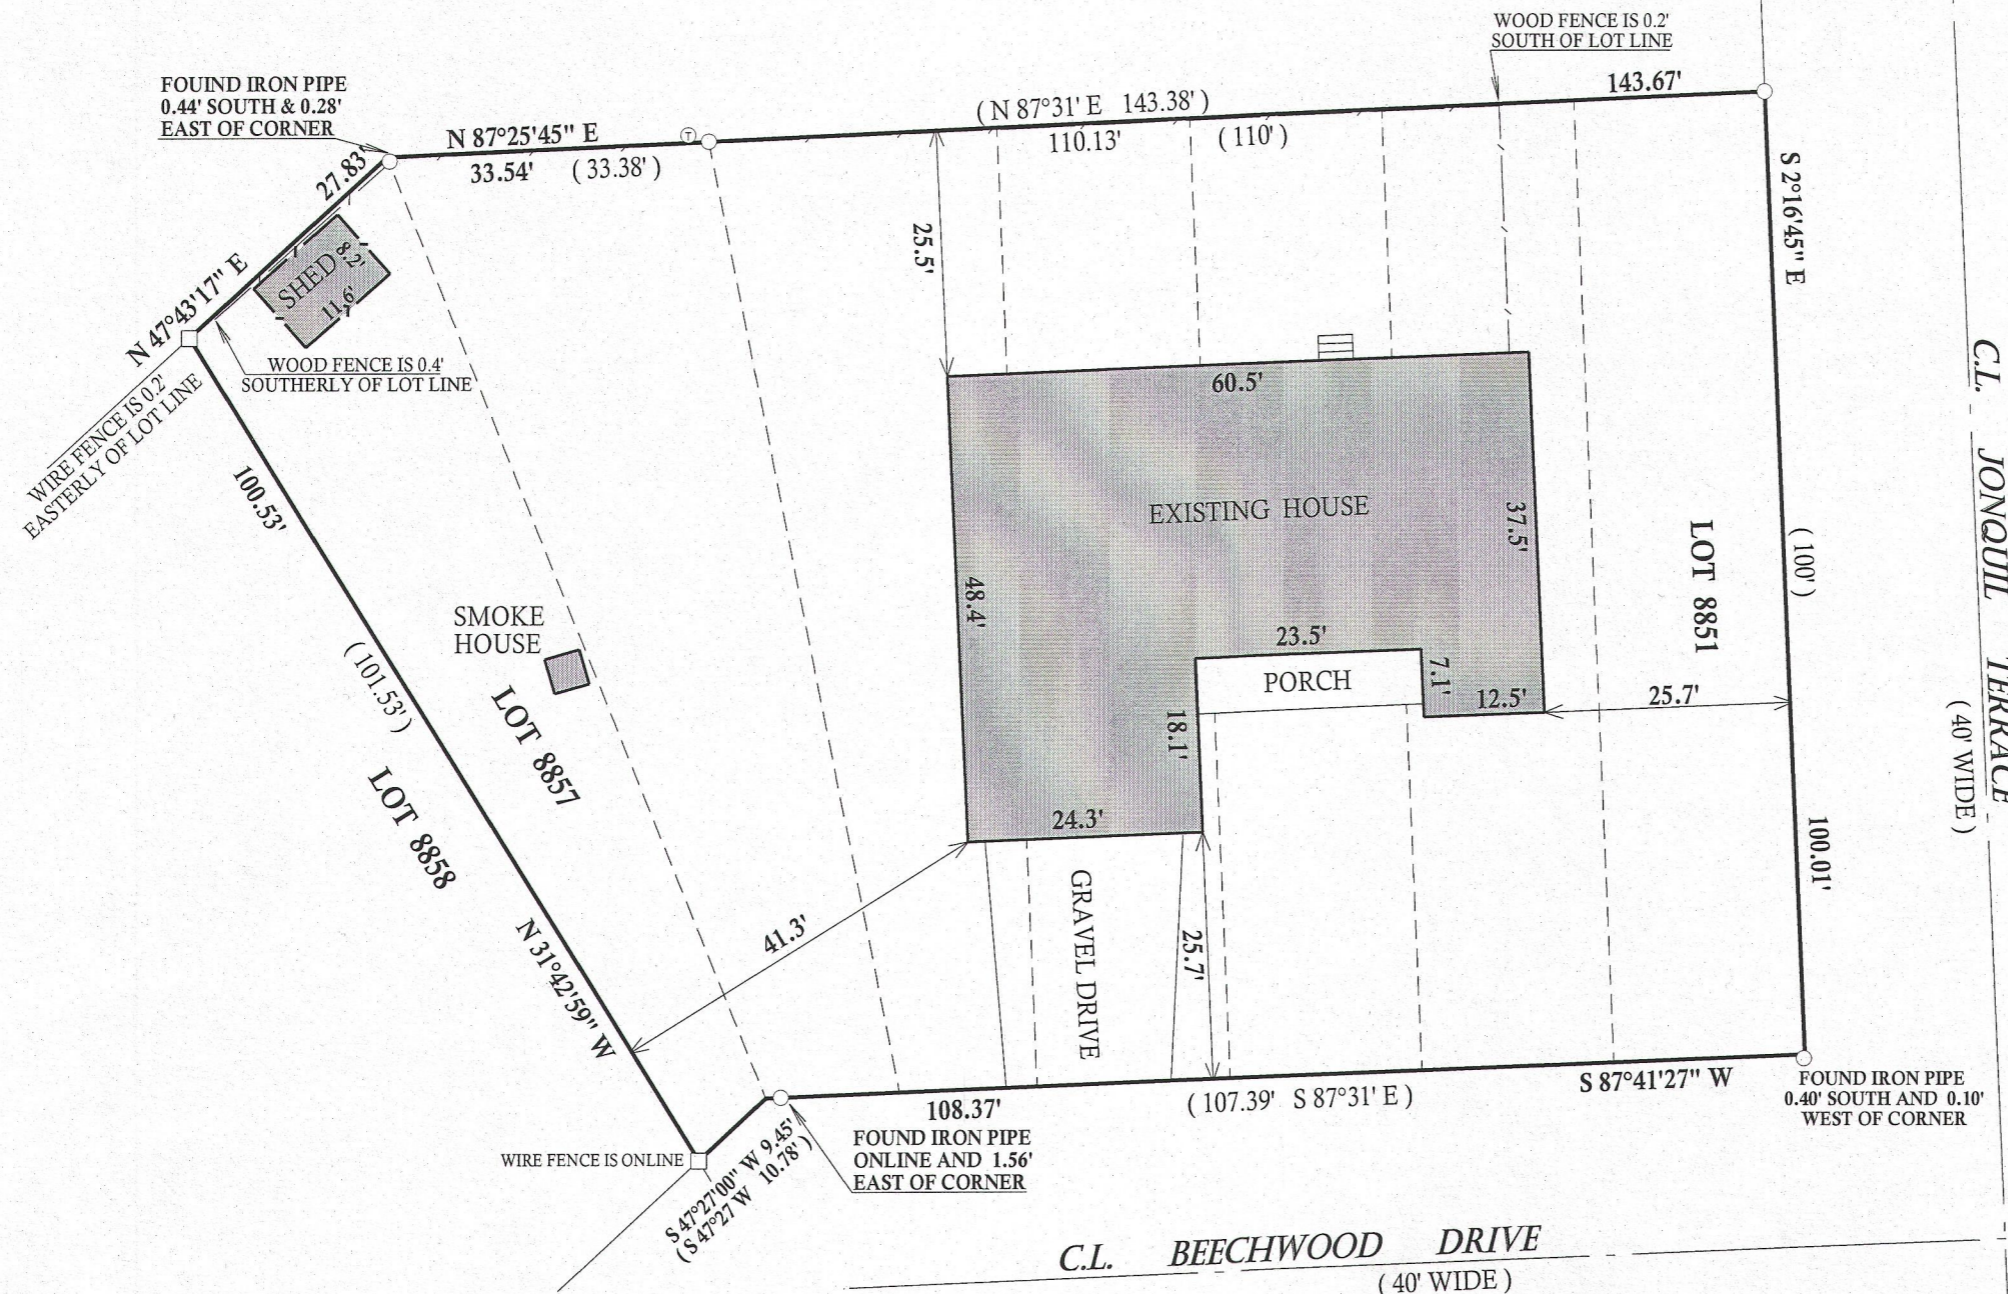



**LEGEND**

- FOUND IRON PIPE
- FOUND IRON BAR
- ⊙ TELEPHONE PEDESTAL
- (xx) RECORDED AS

TAX ID # & PL01779  
 JOB # 13-046

I have surveyed the above-described property and the above map is a true representation thereof and shows the size and location of the property, its exterior boundaries, the location and dimensions of all structures thereon, fences apparent easements and roadways and visible encroachments, if any.

This survey is made for the exclusive use of the present owners of the property, and also those who purchase, mortgage, or insure the title thereto within one (1) year from date hereof; and as to them I warrant the accuracy of said survey map.

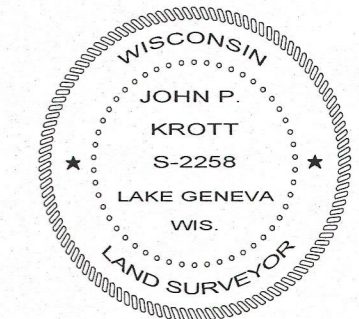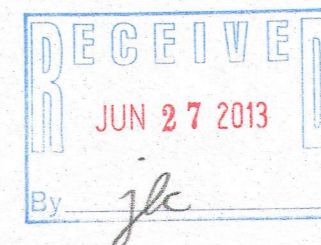

DATED THIS 15th DAY OF APRIL 2013

*John P. Krott*

JOHN KROTT S - 2258  
 Wisconsin Registered Land Surveyor  
 (original if signed in red)

118-3139