

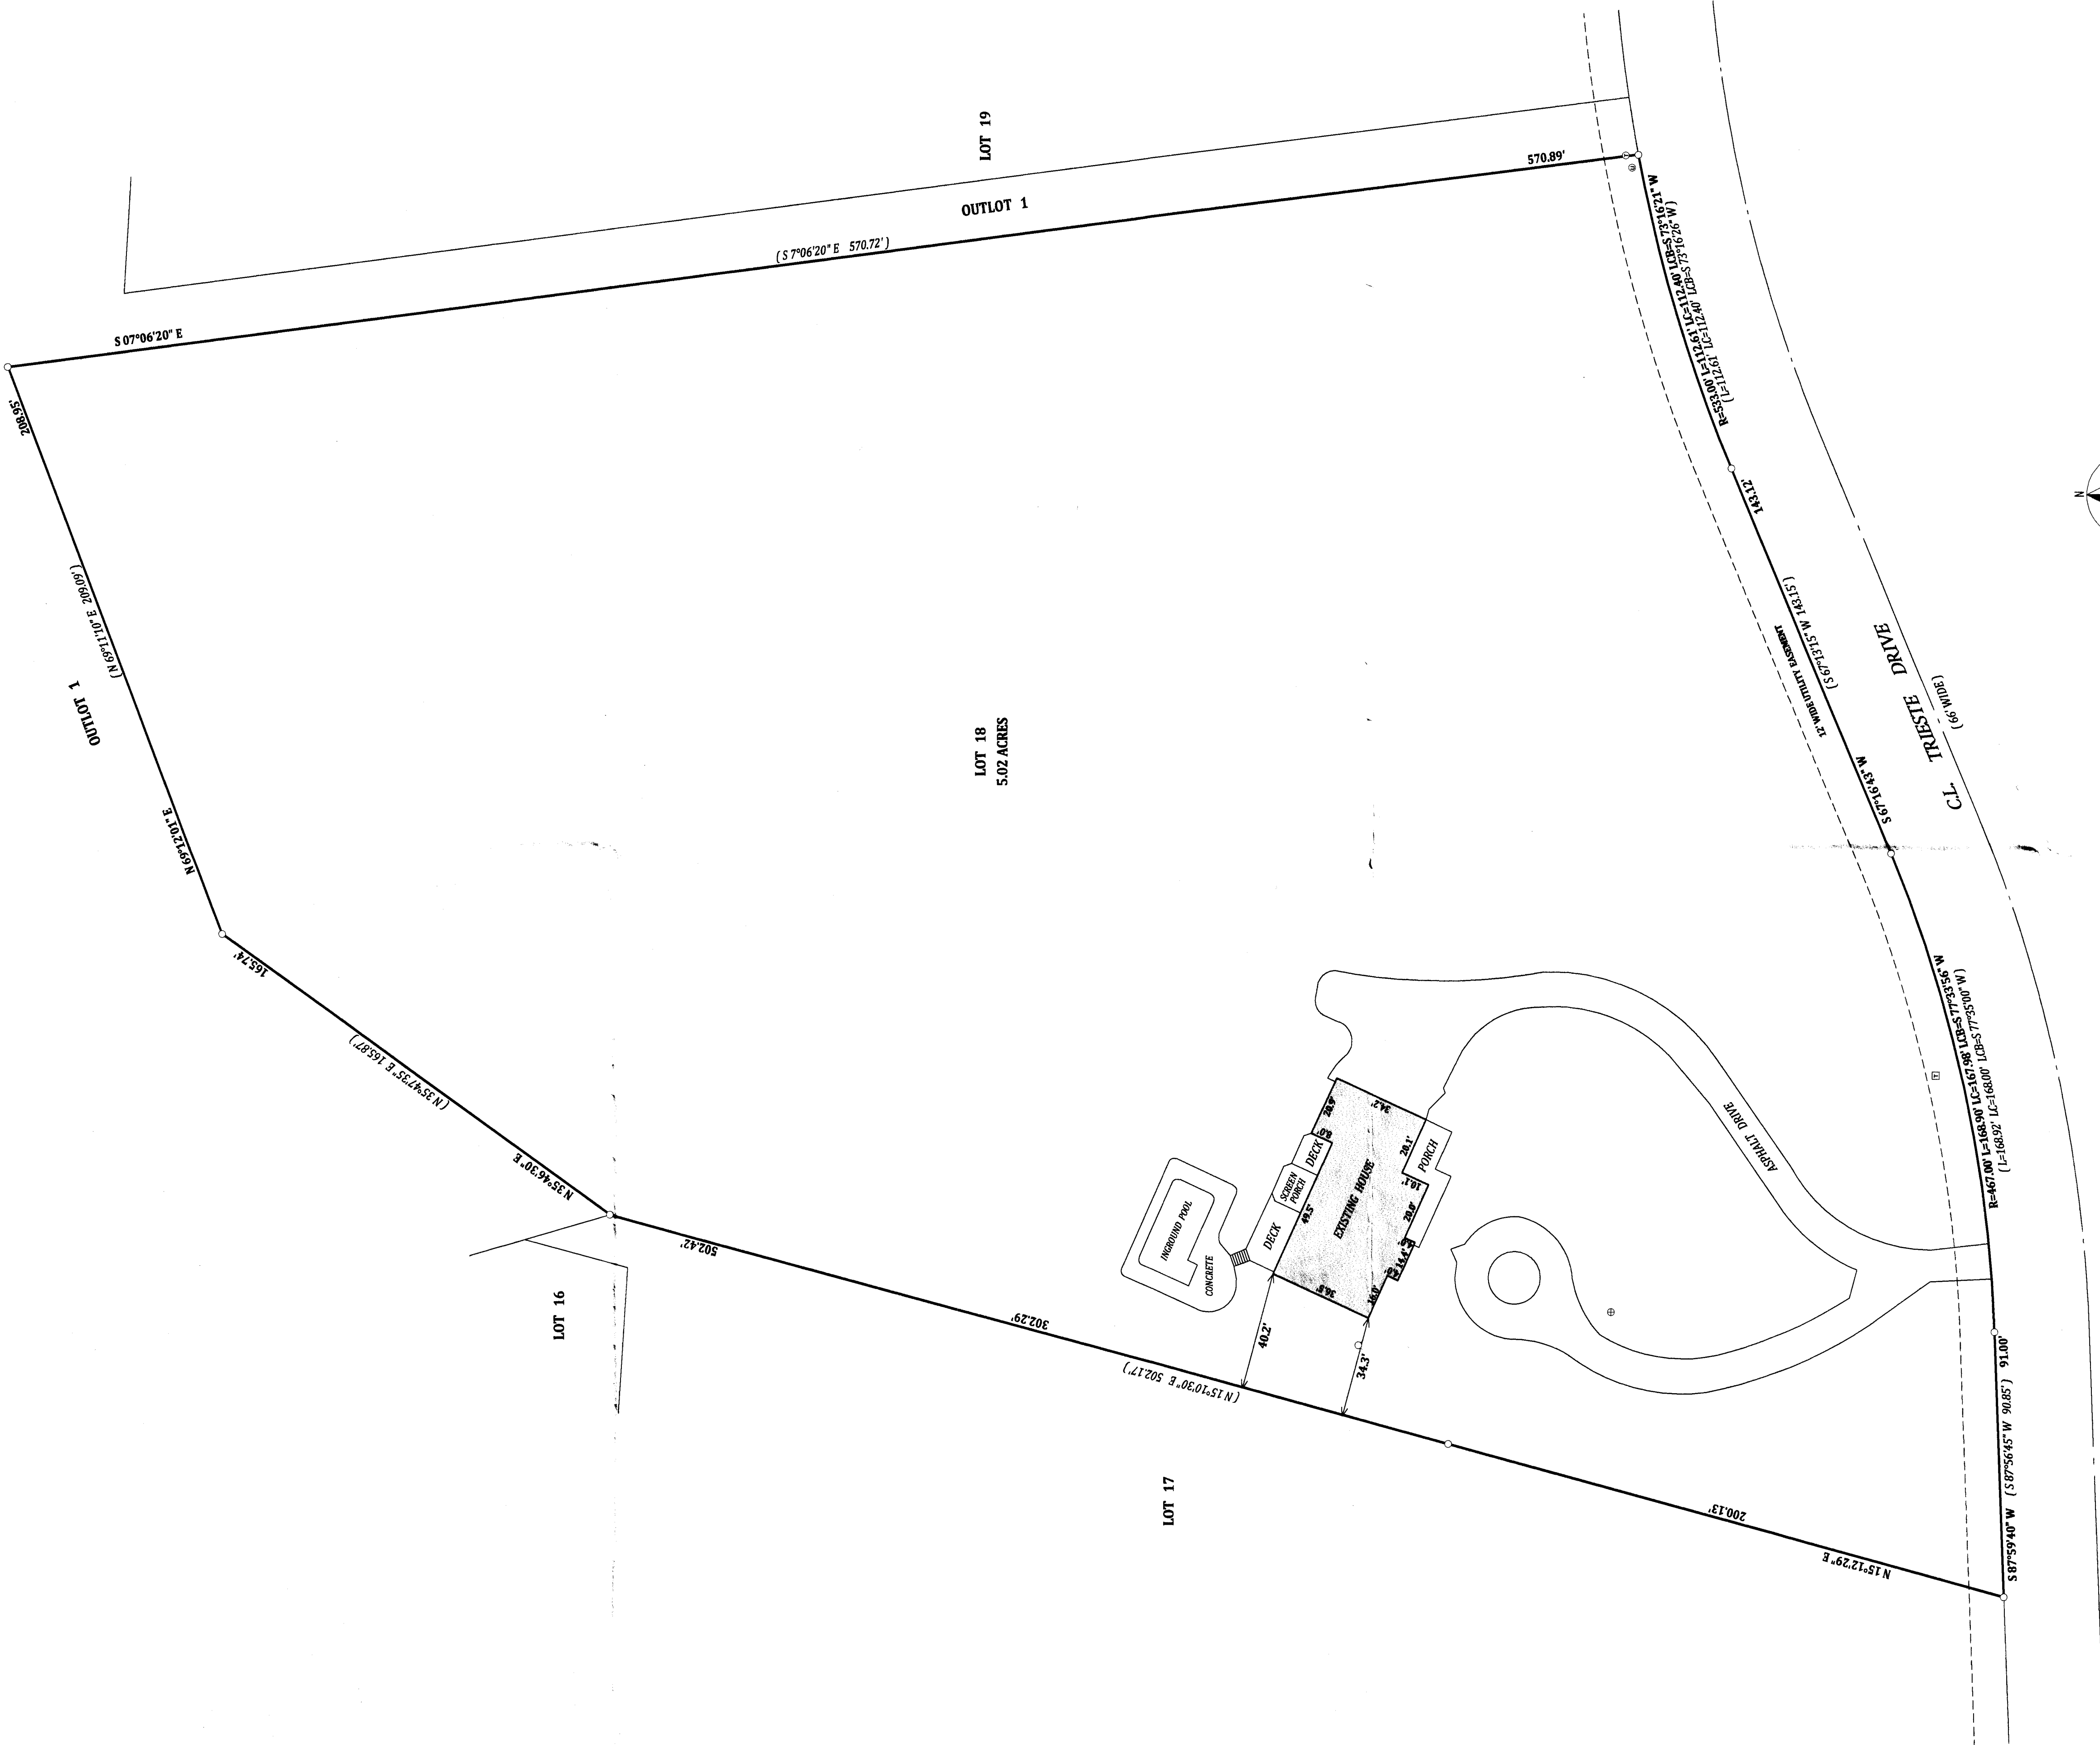
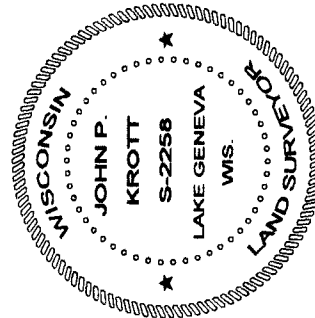


PLAT OF SURVEY OF

LOT 18 IN TUSCANY SUBDIVISION, LOCATED IN THE NORTHWEST 1/4 OF SECTION 3,
TOWN 1 NORTH, RANGE 18 EAST, TOWN OF BLOOMFIELD, WALWORTH COUNTY, WISCONSIN.

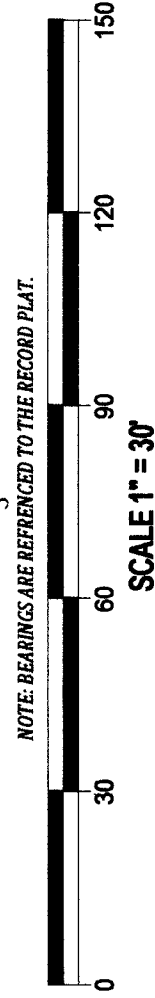


- LEGEND**
- FOUND IRON PIPE
 - ⊕ CONCRETE ACCESS COVER
 - WELL
 - ⊕ UTILITY PEDESTAL
 - ⊕ TELEPHONE PEDESTAL
 - ⊕ TRANSFORMER
 - (XX) RECORDED AS
- TAX ID # MTU00018
JOB # 13-169

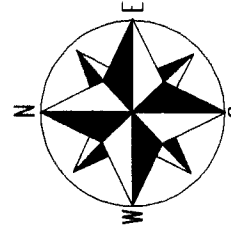

I have surveyed the above-described property and the above map is a true representation thereof and shows the size and location of the property, its exterior boundaries, the location and dimensions of all structures thereon, fences apparent easements and roadways and visible encroachments, if any.

This survey is made for the exclusive use of the present owners of the property, and also those who purchase, mortgage or insure the title thereto within one (1) year from date hereof, and as to them I warrant the accuracy of said survey map.

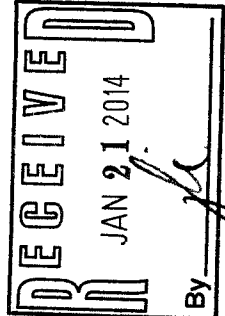

DATED THIS 21st DAY OF NOVEMBER 2013
JOHN P. KROTT S-2258
WISCONSIN REGISTERED LAND SURVEYOR
(NOTE: THIS IS NOT A CERTIFIED COPY
UNLESS SIGNED IN RED INK)