

PREPARED FOR
KRISTIN STAHLAK
KEEFE REAL ESTATE
LAKE GENEVA, WI.


PLAT OF SURVEY

- OF -

LOTS 210, 211, 212, 213 AND 214, BLOCK 4 AND LOTS 269, 270, 271 AND 272, BLOCK 4 OF PELL LAKE HIGHLANDS, ACCORDING TO THE RECORD PLAT THEREOF, AS RECORDED IN THE OFFICE OF THE REGISTER OF DEEDS FOR WALWORTH COUNTY AND THE STATE OF WISCONSIN, ON THE 12TH DAY OF JUNE, 1925 IN VOLUME 8 OF PLATS PAGE 27.

PATHFINDER SURVEYING INC.
(formerly)
J.K. SURVEYING INC.
P.O. BOX 322
LAKE GENEVA, WI. 53147
WWW.PATHFINDERSURVEYING.NET
262-248-8303

EASTWOOD DRIVE

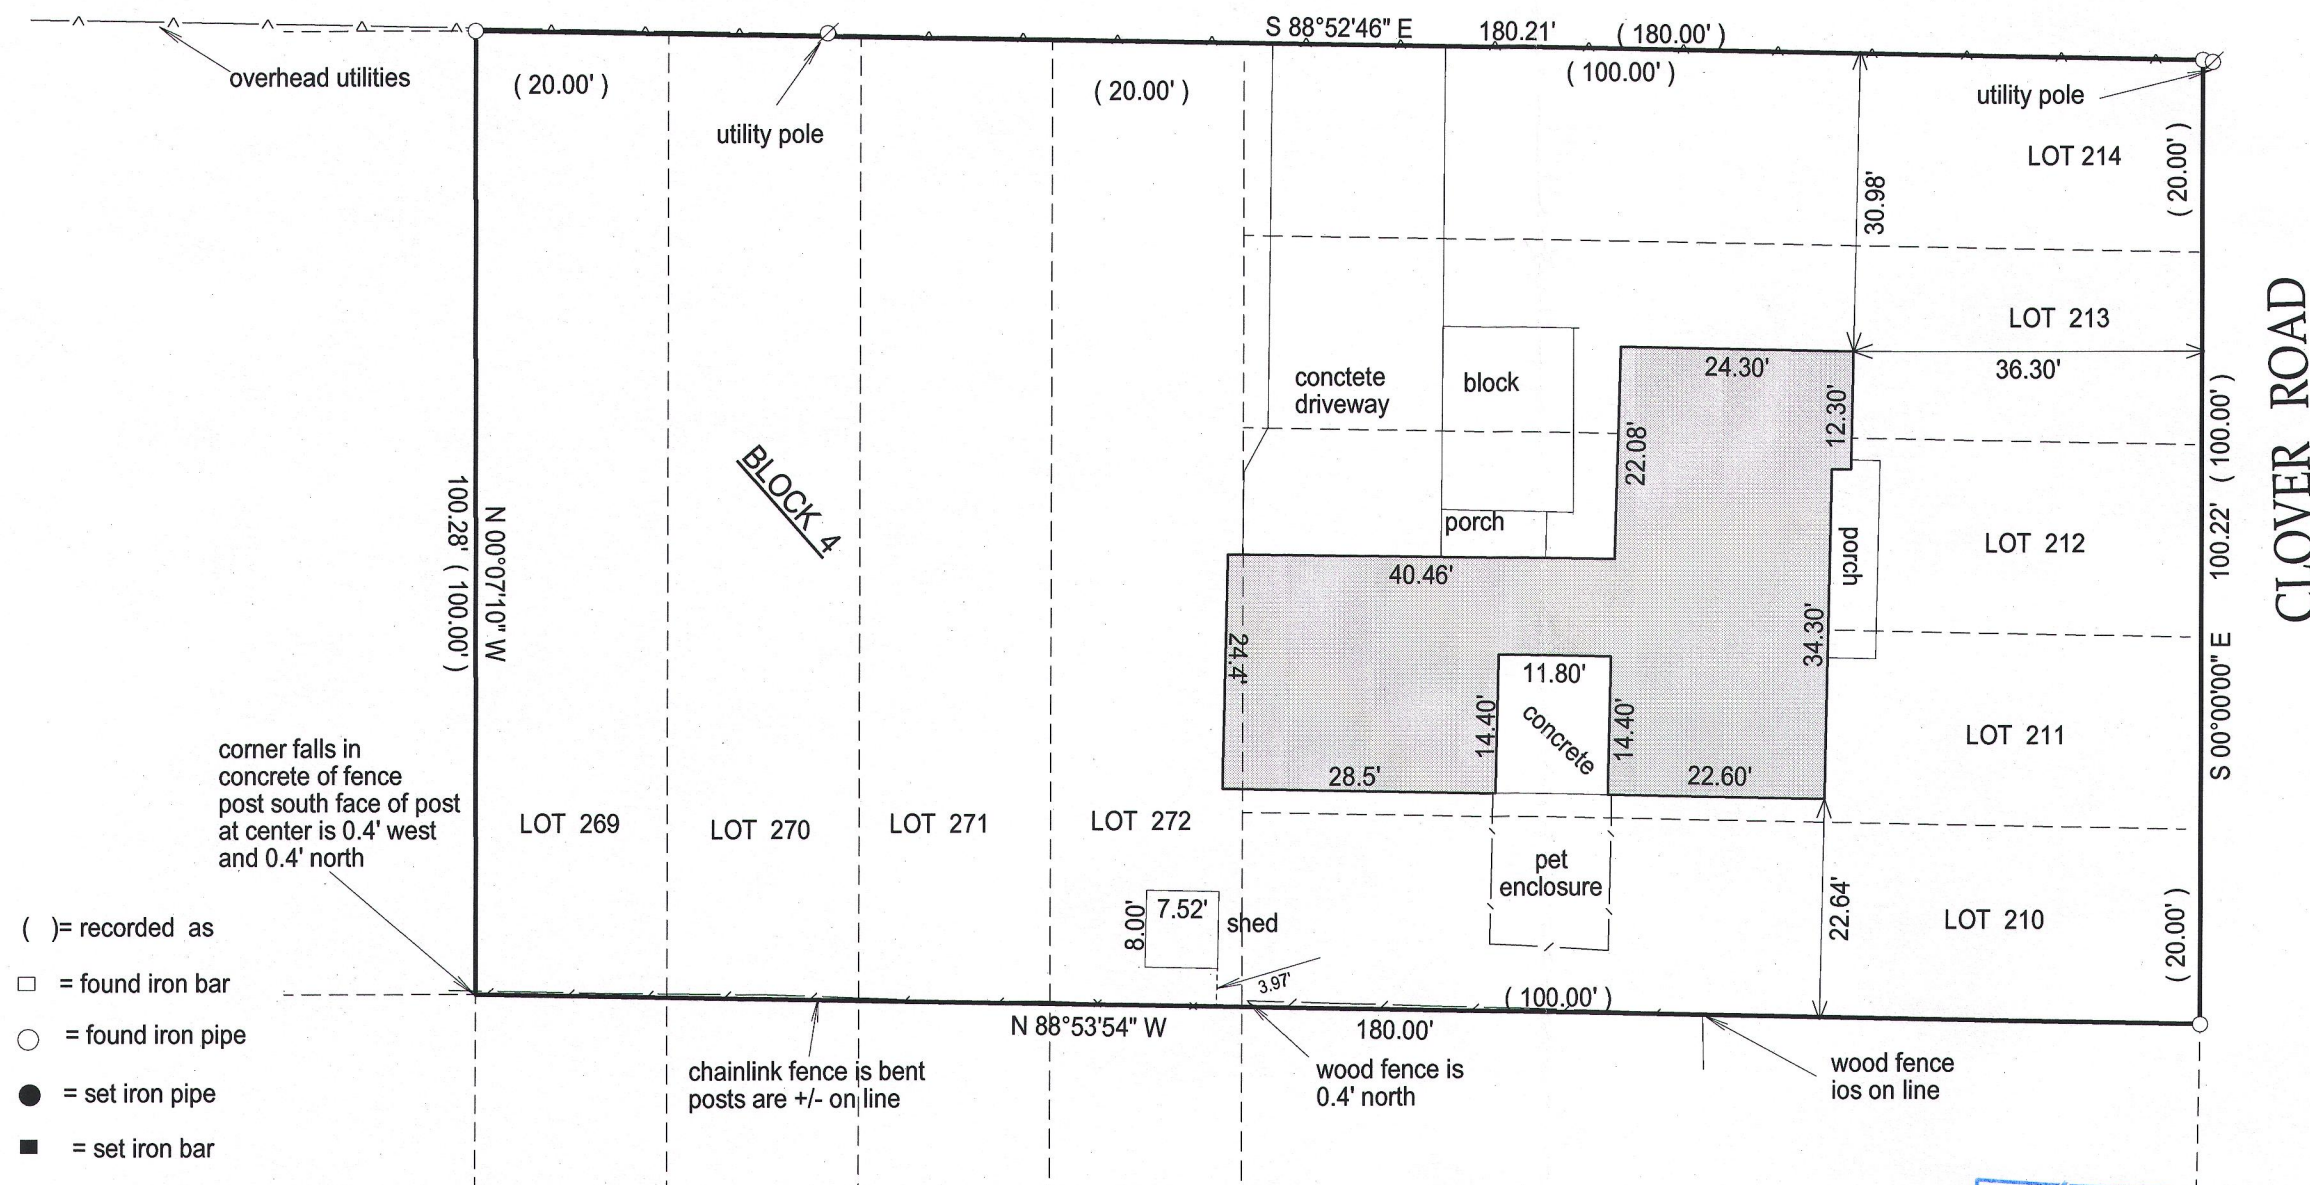

- () = recorded as
- = found iron bar
- = found iron pipe
- = set iron pipe
- = set iron bar

SCALE 1" = 20'



JOB # 15-41

TAX ID # &PLH 00046

"I hereby certify that I have surveyed the above described property and that the above map is a true representation of its exterior boundary and shows the size and location of all visible structures, apparent easements and encroachments if any."


This survey is made for the present owners of the property, and those who purchase, mortgage, or guarantee the title thereto, within one year from the date hereof.

DATED THIS 26th DAY OF FEBRUARY, 2015.

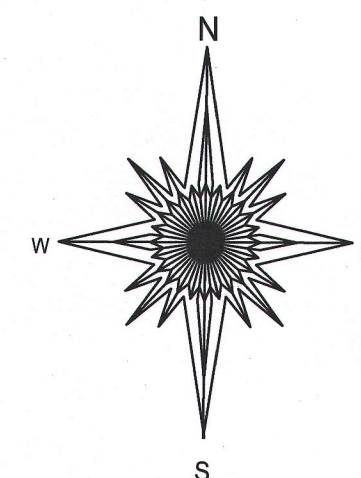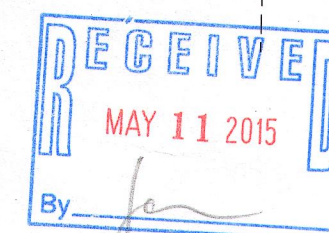

20 0 20 40

BASIS OF BEARING OF THIS PLAT: THE WEST LINE OF CLOVER WAS ASSUMED TO BEAR NORTH.

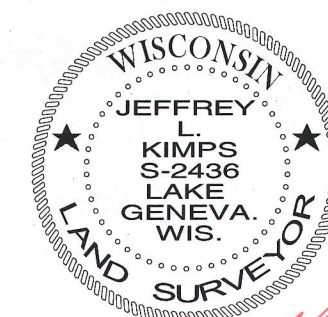

JEFFREY L. KIMPS S-2436
Wisconsin Registered Land Surveyor
(original if signed in red)

8PLH-46 118-3212