
PREPARED FOR BILL NEEL W1312 BERNICE RD GENOA CITY, WI 53128

## PLAT OF SURVEY


- OF -

PATHFINDER SURVEYING INC. ( formerly ) J.K. SURVEYING INC. P.O BOX 322 LAKE GENEVA, WI. 53147 WWW.PATHFINDERSURVEYING.NET 262-248-8303

LOTS 79, 80, 81, 82, AND 83 BLOCK 2 PELL LAKE HIGHLANDS, ACCORDING TO THE RECORD PLAT THEREOF, AS RECORDED IN THE OFFICE OF THE REGISTER OF DEEDS FOR WALWORTH COUNTY AND THE STATE OF WISCONSIN, ON THE 12TH DAY OF JUNE, 1925 IN VOLUME 8 OF PLATS PAGE 27.

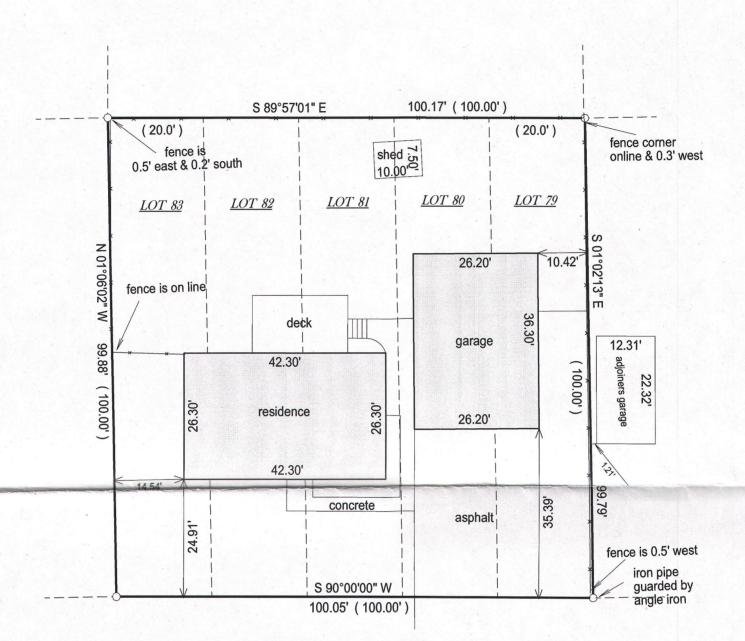

## BERNICE ROAD

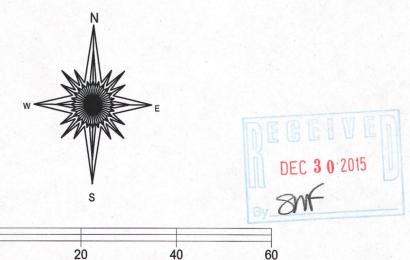

)= recorded as

□ = found iron bar

= found iron pipe

= set iron pipe

= set iron bar

SCALE 1" = 20'

JOB # 15-295

&PLH 00019` TAX ID #

BASIS OF BEARING OF THIS PLAT: THE NORTH LINE OF BERNICE WAS ASSUMED TO BEAR WEST.

I hereby certify that I have surveyed the above- described property and the above map is a is a true representation thereof and shows the size and location of the property, its exterior boundaries, the location and dimensions of all structures thereon, fences, apparant easements and roadways and visible encroachments if any.

This survey is made for the present owners of the property, and those who purchase, mortgage, or guarantee the title thereto, within one year from

DATED THIS 17TH DAY OF SEPTEMBER, 2015.

JEFFREY L KIMPS S-2436 Wisconsin Professional Land Surveyor ( original if signed in red )

WIS.

119 20.12