


PLAT OF SURVEY
-OF-

LOTS 3420, 3421, 3422 AND 3423 IN BLOCK 72, AS DESIGNATED AND DELINEATED ON THE MAP OF PELL LAKE, AND KNOWN AS SECTION 3 OF PELL LAKE SUBDIVISION, AND LOCATED IN SECTION 15, TOWNSHIP 1 NORTH, RANGE 18 EAST OF THE FOURTH PRINCIPAL MERIDIAN, IN THE VILLAGE OF BLOOMFIELD, COUNTY OF WALWORTH AND STATE OF WISCONSIN.

SURVEY FOR: TLC HOME IMPROVEMENTS
SURVEY ADDRESS: W911 MYRTLE ROAD, GENOA CITY, WI 53128

NOTE: REFER TO A CURRENT TITLE REPORT FOR EASEMENTS, RESTRICTIONS OR COVENANTS WHICH MAY AFFECT THIS PROPERTY.


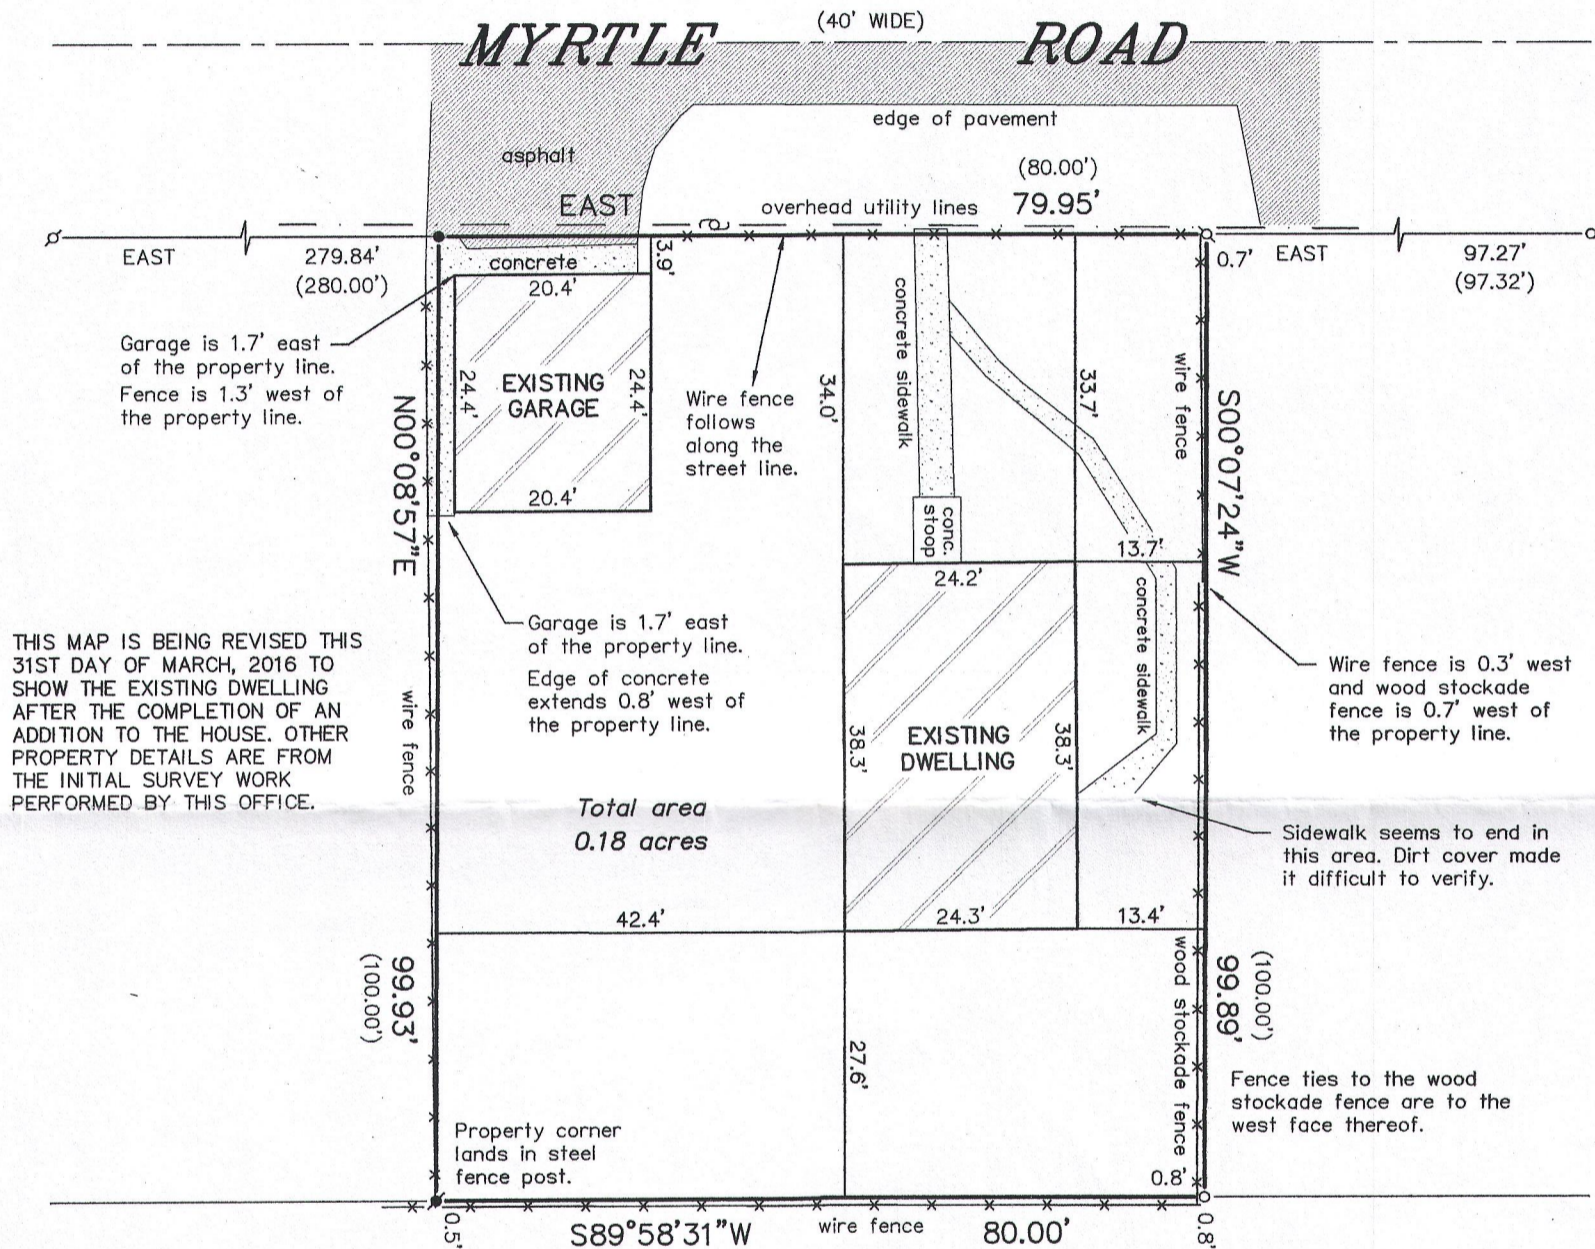


THIS MAP IS BEING REVISED THIS 31ST DAY OF MARCH, 2016 TO SHOW THE EXISTING DWELLING AFTER THE COMPLETION OF AN ADDITION TO THE HOUSE. OTHER PROPERTY DETAILS ARE FROM THE INITIAL SURVEY WORK PERFORMED BY THIS OFFICE.

LEGEND

- FOUND IRON PIPE
- ⊘ FOUND IRON ROD
- SET LANDSCAPING NAIL
- ⊙ SET IRON PIPE
- ⊕ 2" DIAMETER FENCE POST
- ⊚ UTILITY POLE
- () RECORDED AS


BEARINGS HEREON RELATE TO THE SOUTH RIGHT-OF-WAY LINE OF MYRTLE ROAD AS DEPICTED HEREON. ASSUMED BEARING OF EAST.

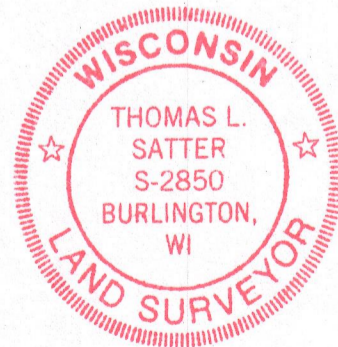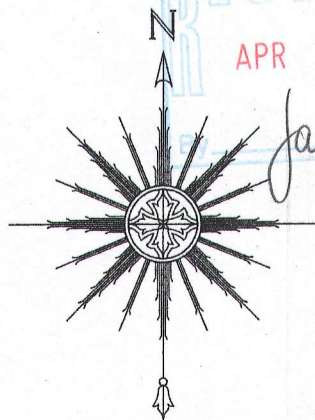

THIS IS NOT AN ORIGINAL PRINT UNLESS THIS SEAL IS RED.

Thomas L. Satter
THOMAS L. SATTER S-2850

SATTER SURVEYING, LLC
LAND SURVEYS, MAPPING AND PLANNING
272 ORIGEN STREET
BURLINGTON, WI 53105
262-661-4239

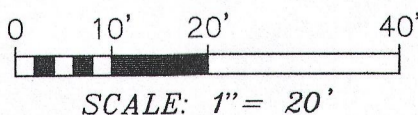

REVISED: 3/31/16
APRIL 13, 2015
DATE

041503
JOB NUMBER

R PL -712

118-3254