


LOTS 4654, 4655, 4656, 4657 AND 4658, BLOCK 90, PELL LAKE SECTION 3, VILLAGE OF BLOOMFIELD, COUNTY OF WALWORTH, STATE OF WISCONSIN.

SURVEY FOR: GENEVA CONCRETE LLC
SURVEY ADDRESS: N1344 MOSS DRIVE

EXISTING TOP OF FOUNDATION = 101.7'

NOTE: REFER TO A CURRENT TITLE REPORT FOR EASEMENTS, RESTRICTIONS OR COVENANTS WHICH MAY AFFECT THIS PROPERTY.

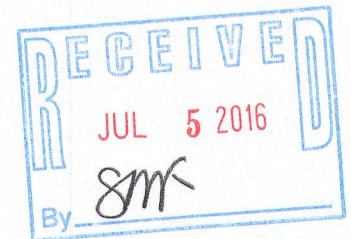


LEGEND

- | | |
|-------|--------------------|
| o | FOUND IRON PIPE |
| ∅ | FOUND IRON ROD |
| ● | SET IRON PIPE |
| ⌘ | UTILITY POLE |
| 100.0 | EXISTING ELEVATION |
| () | RECORDED AS |

NOTE: THE PURPOSE OF THIS SURVEY IS TO SHOW THE EXISTING FOUNDATION AND ITS PROXIMITY TO THE PROPERTY LINES. ALL OTHER PROPERTY DETAILS ARE FROM PREVIOUS SURVEY WORK PERFORMED BY THIS OFFICE AND WERE NOT RE-VERIFIED AS PART OF THIS SURVEY.

BEARINGS HEREON RELATE TO THE WEST LINE
OF BLOCK 90 OF PELL LAKE SECTION 3.
ASSUMED BEARING OF NORTH.

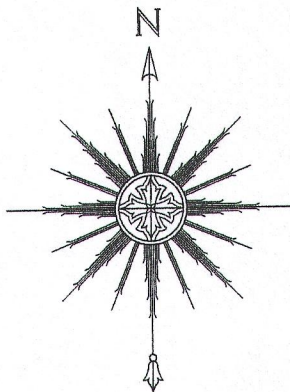

"I HEREBY CERTIFY THAT I HAVE SURVEYED THE ABOVE DESCRIBED PROPERTY AND THAT THE ABOVE MAP IS A CORRECT REPRESENTATION THEREOF AND SHOWS THE SIZE AND LOCATION OF THE PROPERTY, ITS EXTERIOR BOUNDARIES, THE LOCATION OF ALL VISIBLE STRUCTURES AND DIMENSIONS OF ALL PRINCIPAL BUILDINGS THEREON, BOUNDARY FENCES, APPARENT EASEMENTS, ROADWAYS AND ENCROACHMENTS, IF ANY."

"THIS SURVEY IS MADE FOR THE USE OF THE PRESENT OWNERS OF THE PROPERTY, AND THOSE WHO PURCHASE, MORTGAGE, OR GUARANTEE THE TITLE THERETO WITHIN ONE YEAR FROM DATE HEREOF."

SATTER SURVEYING, LLC
LAND SURVEYS, MAPPING AND PLANNING
272 ORIGEN STREET
BURLINGTON, WI 53105
262-661-4239

THIS IS NOT AN ORIGINAL PRINT
UNLESS THIS SEAL IS RED.

Thomas L. Satter

THOMAS L. SATTER S-2850

JUNE 18, 2016
DATE

121502-AS BUILT
JOB NUMBER

6PL-993

118-3265