
PLAT OF SURVEY -OF-

LOTS 951 THROUGH 955, INCLUSIVE, IN BLOCK 16 OF PELL LAKE ADDITION, A SUBDIVISION LYING IN THE WEST 1/2 OF THE SOUTHWEST 1/4 OF SECTION 14 AND THE NORTH 1/2 OF THE NORTH 1/2 OF THE NORTHWEST 1/4 OF SECTION 23, ALL IN TOWNSHIP 1 NORTH, RANGE 18 EAST OF THE FOURTH PRINCIPAL MERIDIAN, IN THE VILLAGE OF BLOOMFIELD, WALWORTH COUNTY, WISCONSIN.

SURVEY FOR: FISCUS ENTERPRISES INC.

SURVEY ADDRESS: W885 CAMELIA ROAD, GENOA CITY, WI 53128

NOTE: REFER TO A CURRENT TITLE REPORT FOR EASEMENTS, RESTRICTIONS OR COVENANTS WHICH MAY AFFECT THIS PROPERTY.

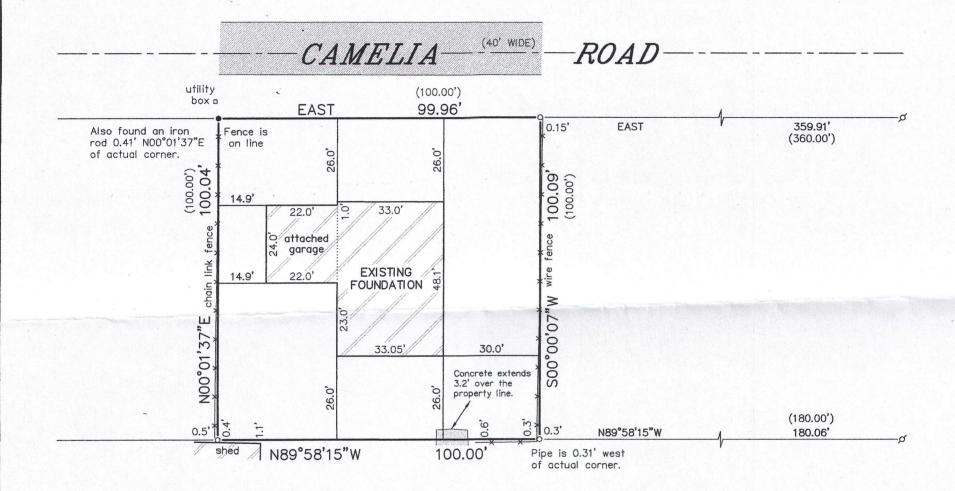

LEGEND

- O FOUND IRON PIPE
- Ø FOUND IRON ROD
- SET IRON PIPE
- () RECORDED AS

"I HEREBY CERTIFY THAT I HAVE SURVEYED THE ABOVE DESCRIBED PROPERTY AND THAT THE ABOVE MAP IS A CORRECT REPRESENTATION THEREOF AND SHOWS THE SIZE AND LOCATION

OF THE PROPERTY, ITS EXTERIOR BOUNDARIES, THE LOCATION OF ALL VISIBLE STRUCTURES AND DIMENSIONS OF ALL PRINCIPAL BUILDINGS THEREON, BOUNDARY FENCES, APPARENT EASEMENTS, ROADWAYS AND ENCROACHMENTS, IF ANY."

"THIS SURVEY IS MADE FOR THE USE OF THE PRESENT OWNERS OF THE PROPERTY, AND THOSE WHO PURCHASE, MORTGAGE, OR GUARANTEE THE TITLE THERETO WITHIN ONE YEAR FROM DATE

BEARINGS HEREON RELATE TO THE NORTH LINE OF BLOCK 16 OF PELL LAKE ADDITION. ASSUMED BEARING OF EAST.





THIS IS NOT AN ORIGINAL PRINT UNLESS THIS SEAL IS RED.

Thomas L. Satter

THOMAS L. SATTER

S-2850

SATTER SURVEYING, LLC

LAND SURVEYS, MAPPING AND PLANNING 272 ORIGEN STREET BURLINGTON, WI 53105 262-661-4239 0 15' 30' 60' SCALE: 1" = 30'

NOVEMBER 10, 2016
DATE

101605

JOB NUMBER