
LOCATED IN THE SW 1/4 & SE 1/4 OF THE SW 1/4 OF SECTION 14,
TOWN 1 NORTH, RANGE 18 EAST,
WALWORTH COUNTY, WISCONSIN

VIOLET ROAD 66' WIDE ROW

EDGE PAVED ROAD \_

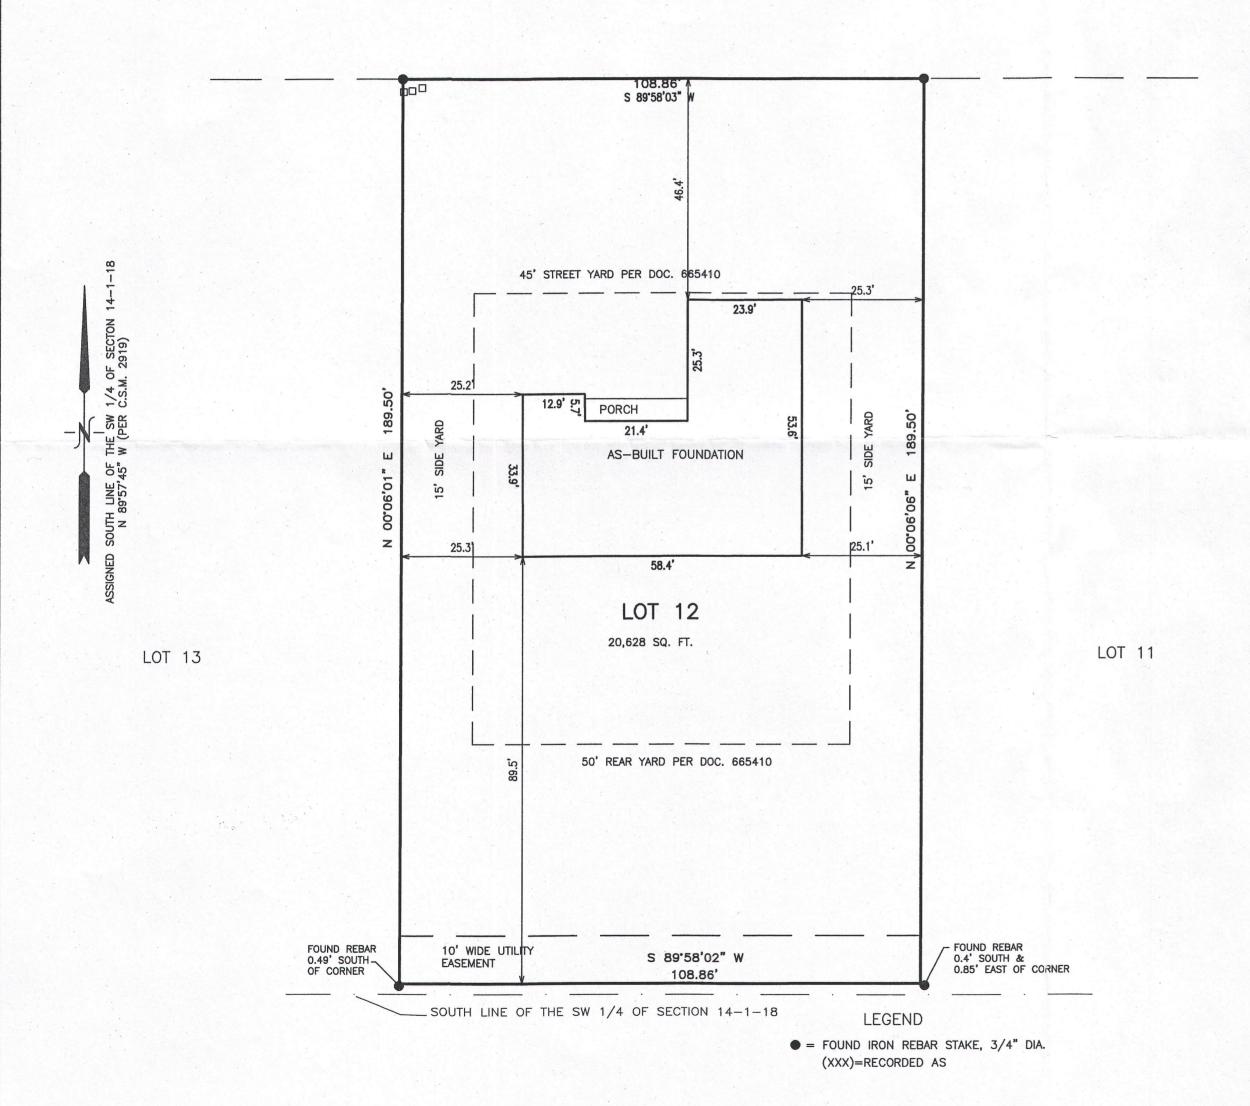

GORDON S-2101 ELKHORN,

NOTE: COPIES OF THIS MAP TO WHICH THE FOLLOWING CERTIFICATE WILL APPLY SHOW THE SURVEYOR'S ORIGINAL SEAL AND SIGNATURE IN RED INK. COPIES BY ANY OTHER MEANS MAY HAVE ALTERATIONS WHICH DO NOT REPRESENT THE SURVEYOR'S WORK PRODUCT.

I HEREBY CERTIFY THAT THE ABOVE DESCRIBED PROPERTY HAS BEEN SURVEYED UNDER MY DIRECTION AND THAT THE ABOVE MAP IS A TRUE REPRESENTATION THEREOF AND SHOWS THE SIZE AND LOCATION OF THE PROPERTY AND ITS EXTERIOR BOUNDARIES. THIS SURVEY IS MADE FOR THE USE OF THE PRESENT OWNERS OF THE PROPERTY, AND ALSO THOSE WHO PURCHASE, MORTGAGE, OR GUARANTEE THE TITLE THERETO WITHIN ONE YEAR FROM THE DATE HEREOF.

DATED: JULY 7,2016

REVISED 09-08-2016 TO SHOW PROPOSED RESIDENCE REVISED 12-30-2016-CB TO SHOW SIZE AND LOCATION OF AS-BUILT FOUNDATION

PETER S. GORDON P.L.S. 2101

PROJECT NO. 5048.12

REVISIONS

DATE: 7-07-2016 SHEET NO. 1 OF 1

1107 63

3

20 10 0

MAP SCALE IN FEET - ORIGINAL 1"=20"