PREPARED FOR MIREYA SANCHEZ P.O. BOX 236 PELL ALE WI. 53157

PLAT OF SURVEY

- OF -

PATHFINDER SURVEYING INC.

(formerly)

J.K. SURVEYING INC.


P.O BOX 322

LAKE GENEVA, WI. 53147

WWW.PATHFINDERSURVEYING.NET
262-248-8303

LOTS 856, THRU 860, BLOCK 12, PELL LAKE HIGHLANDS, A SUBDIVISION LOCATED IN SECTION 16, TOWN 1 NORTH, RANGE 18 EAST, VILLAGE OF BLOOMFIELD, COUNTY OF WALWORTH AND STATE OF WISCONSIN.

OAKWOOD ROAD

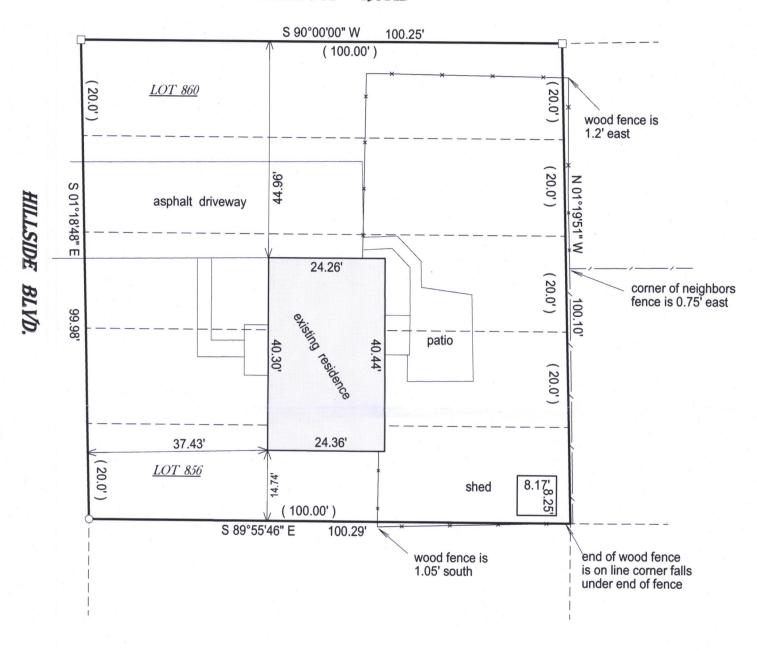




- = found iron bar
- = found iron pipe
- = set iron pipe
- = set iron bar

SCALE 1" = 20'

JOB # 17-20

TAX ID # &PLH 00182

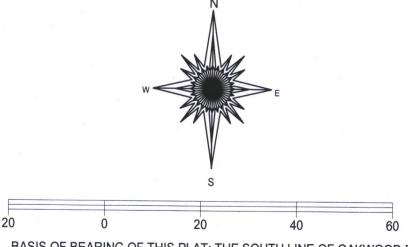

BASIS OF BEARING OF THIS PLAT: THE SOUTH LINE OF OAKWOOD RD. WAS ASSUMED TO BEAR WEST AS MONUMENTED.

I hereby certify that I have surveyed the above- described property and the above map is a is a true representation thereof and shows the size and location of the property, its exterior boundaries, the location and dimensions of all structures thereon, fences, apparant easements and roadways and visible encroachments if any.

This survey is made for the present owners of the property, and those who purchase, mortgage, or guarantee the title thereto, within one year from the date hereof.

DATED THIS 4th day of February, 2017.



JEFFREY

KIMPS
S-2436
LAKE
GENEVA.

WIS.

JEFFREY L/KMMPS S - 2436 Wisconsin Professional Land Surveyor

(original if signed in red)