


PLAT OF SURVEY

-OF-

LOTS 4209 THROUGH 4215 IN BLOCK 84, PELL LAKE SECTION 3, ACCORDING TO THE RECORDED SUBDIVISION PLAT THEREOF. SAID LAND BEING IN THE VILLAGE OF BLOOMFIELD, COUNTY OF WALWORTH AND STATE OF WISCONSIN.

SURVEY FOR: MTM REALTY, INC.
SURVEY ADDRESS: W975 HYACINTH ROAD, GENOA CITY, WI 53128

NOTE: REFER TO A CURRENT TITLE REPORT FOR EASEMENTS, RESTRICTIONS OR COVENANTS WHICH MAY AFFECT THIS PROPERTY.

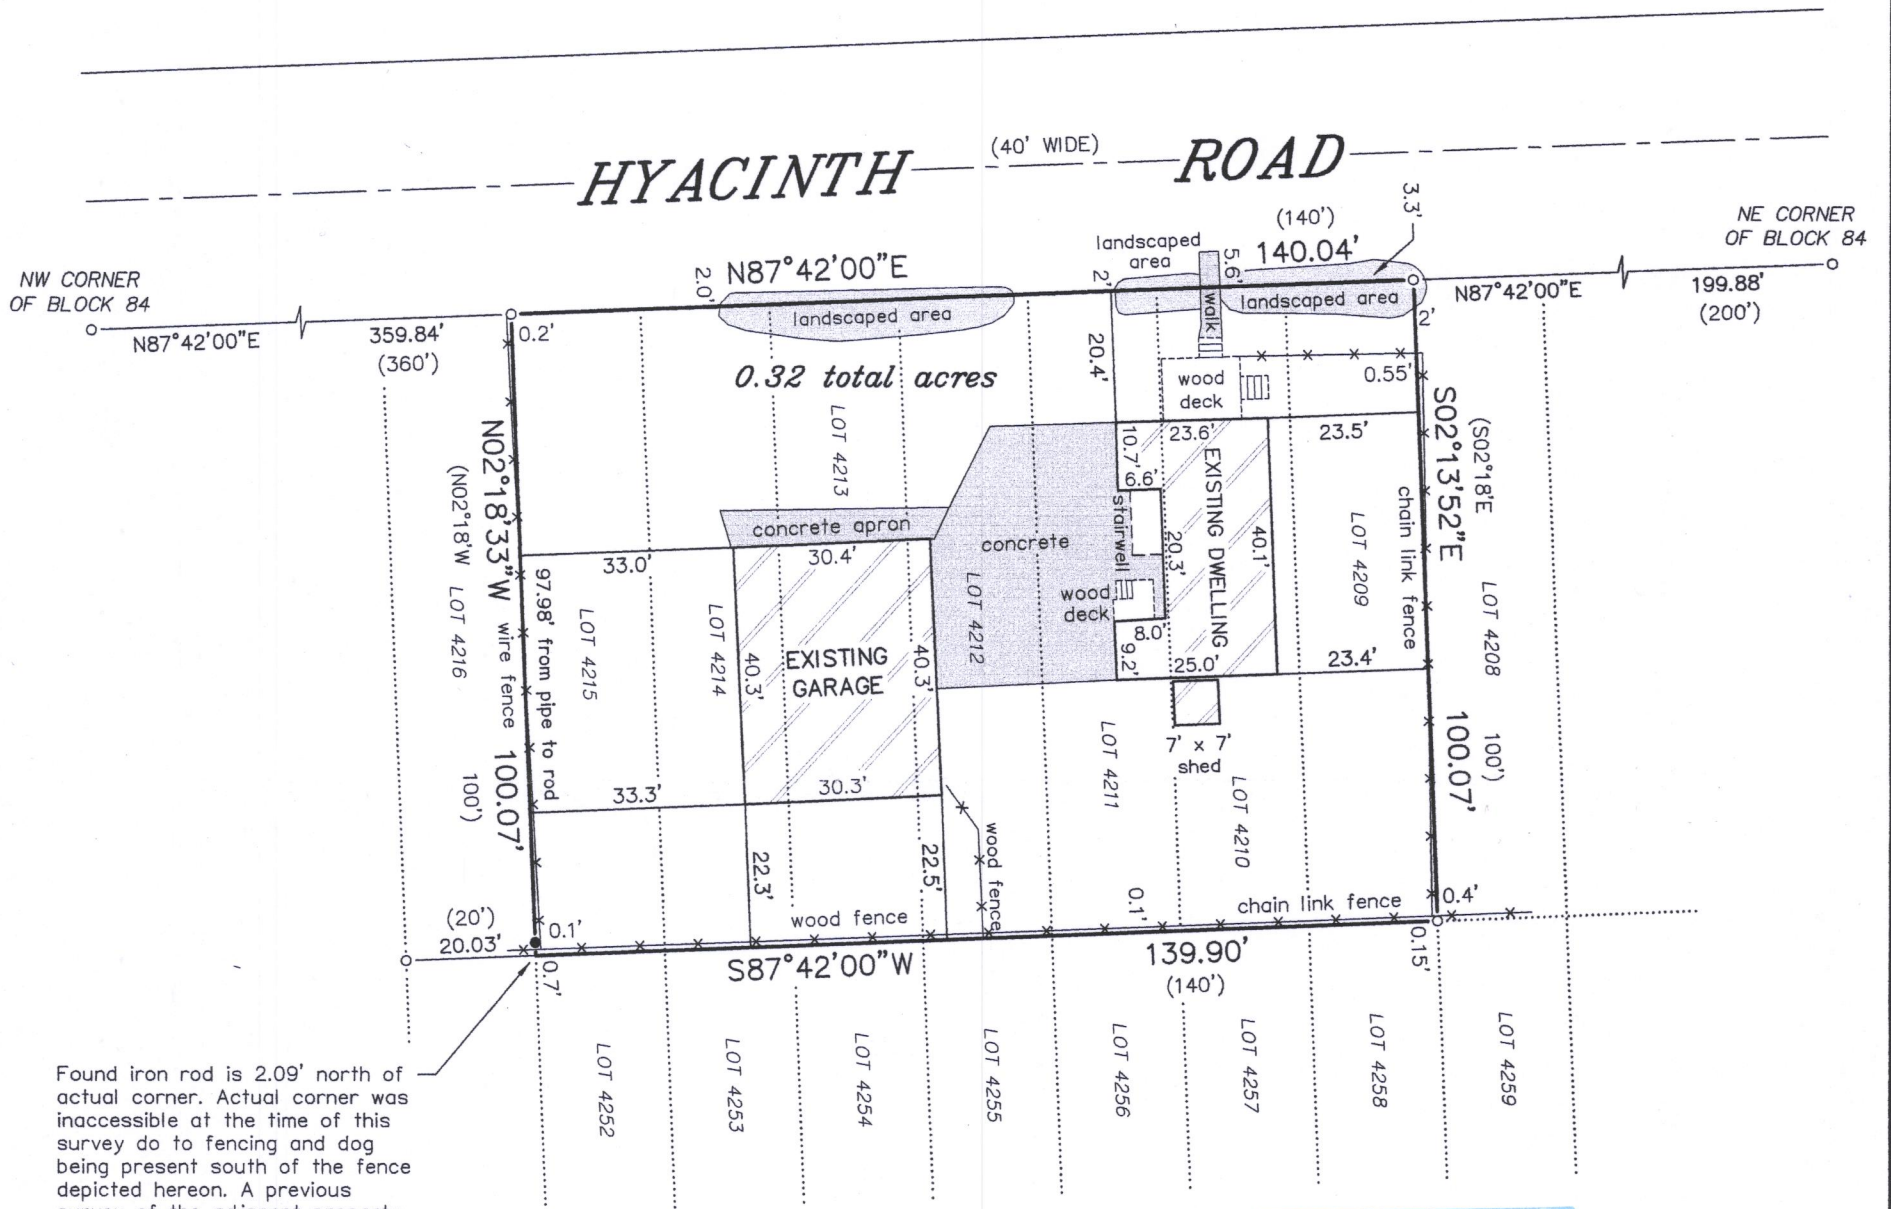



Found iron rod is 2.09' north of actual corner. Actual corner was inaccessible at the time of this survey do to fencing and dog being present south of the fence depicted hereon. A previous survey of the adjacent property to the west performed by Krott Surveying Inc. and dated June 9, 2008 states that the iron bar was set on line 2.00' north of corner and that concrete for fence post is at the corner.



LEGEND

- FOUND IRON PIPE
- FOUND IRON ROD
- () RECORDED AS

BEARINGS HEREON RELATE TO THE NORTH LINE OF BLOCK 84 OF SECTION 3 OF PELL LAKE SUBDIVISION. ASSUMED BEARING OF NORTH 87°42'00" EAST AS PLATTED.

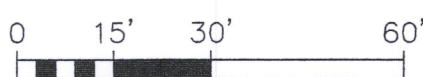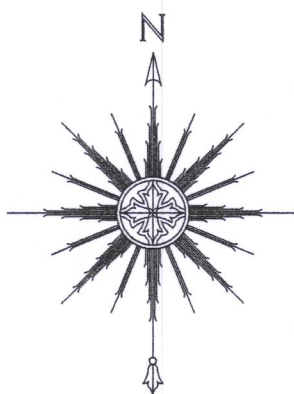

SCALE: 1" = 30'



THIS IS NOT AN ORIGINAL PRINT
UNLESS THIS SEAL IS RED.

Thomas L. Satter

THOMAS L. SATTER

S-2850

JULY 22, 2017
DATE

071704
JOB NUMBER

SATTER SURVEYING, LLC
LAND SURVEYS, MAPPING AND PLANNING
272 ORIGIN STREET
BURLINGTON, WI 53105
262-661-4239

8PL-888

118-3323