
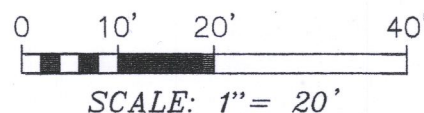


BEARINGS HEREON RELATE TO THE SOUTH
LINE OF BLOCK 19 OF "PELL LAKE
HIGHLANDS". ASSUMED BEARING OF WEST.

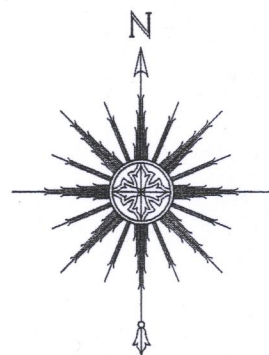

LEGEND

- FOUND IRON PIPE
- FOUND IRON ROD
- () RECORDED AS

"I HEREBY CERTIFY THAT I HAVE SURVEYED THE ABOVE DESCRIBED PROPERTY AND THAT THE ABOVE MAP IS A CORRECT REPRESENTATION THEREOF AND SHOWS THE SIZE AND LOCATION OF THE PROPERTY, ITS EXTERIOR BOUNDARIES, THE LOCATION OF ALL VISIBLE STRUCTURES AND DIMENSIONS OF ALL PRINCIPAL BUILDINGS THEREON, BOUNDARY FENCES, APPARENT EASEMENTS, ROADWAYS AND ENCROACHMENTS, IF ANY."

"THIS SURVEY IS MADE FOR THE USE OF THE PRESENT OWNERS OF THE PROPERTY, AND THOSE WHO PURCHASE, MORTGAGE, OR GUARANTEE THE TITLE THERETO WITHIN ONE YEAR FROM DATE HEREOF."

SATTER SURVEYING, LLC
LAND SURVEYS, MAPPING AND PLANNING
272 ORIGIN STREET
BURLINGTON, WI 53105
262-661-4239

NOTE: REFER TO A CURRENT TITLE REPORT FOR EASEMENTS, RESTRICTIONS OR COVENANTS WHICH MAY AFFECT THE USE OF THIS PROPERTY.

LOT 395 LOT 396 LOT 397 LOT 398 LOT 399 LOT 400 LOT 401 LOT 402

EAST

chain link fence

0.3' 0.3' 0.15'

160.00'

60.00'

utility box

0.6'

concrete slab

Last fence post on the subject property is 0.1' south of the north property line.

LOT 362

concrete stoop

LOT 361

LOT 360

47.4'

LOT 359

concrete slab

chain link fence

S01°12'15"E

0.7'

LOT 358

0.37 acres

(100.00')

99.93'

LOT 357

arbor

LOT 356

LOT 355

(100.00')

99.93'

WEST

200.00'

160.00'

60.00'

100.00'

24.5'

24.2'

35.9'

27.9'

57.1'

15.1'

21.9'

16.9'

4.2'

4.0'

10.1'

EXISTING DWELLING

attached garage

concrete driveway

porch

chain link fence

99.93'

(100.00')

120.11'

(120.00')

WEST

0.7'

Pipe is 0.35' south and 0.24' west of actual corner.

water valve

GREENVIEW

(40' WIDE)

-ROAD

PLAT OF SURVEY
-OF-

LOTS 356-363 IN BLOCK 19 OF "PELL LAKE HIGHLANDS", ACCORDING TO THE RECORDED PLAT THEREOF. SAID LAND BEING IN THE VILLAGE OF BLOOMFIELD, COUNTY OF WALWORTH AND STATE OF WISCONSIN.


SURVEY FOR: PETER LOMBARDO
SURVEY ADDRESS: W1382 GREENVIEW ROAD, GENOA CITY, WI 53128



THIS IS NOT AN ORIGINAL PRINT
UNLESS THIS SEAL IS RED.

QPLH-78

QPLH-79

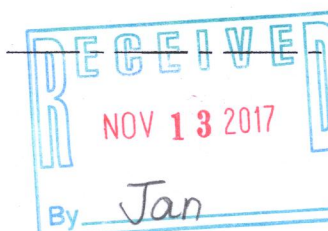

Thomas L. Satter

THOMAS L. SATTER

S-2850

OCTOBER 5, 2017
DATE

081713
JOB NUMBER

118-3338