
## PLAT OF SURVEY -OF-

LOT 5 IN BLOCK 3 OF "ROSE NIPPERSINK GARDENS", A SUBDIVISION BEING A PART OF THE SOUTHEAST 1/4 OF SECTION 24, TOWN 1 NORTH, RANGE 18 EAST, VILLAGE OF BLOOMFIELD, ACCORDING TO THE PLAT RECORDED IN VOLUME 11 OF PLATS, PAGES 31 AND 32, LYING AND BEING IN WALWORTH COUNTY, WISCONSIN.

SURVEY FOR: LAKE GENEVA AREA REALTY SURVEY ADDRESS: N1012 IRIS AVENUE, GENOA CITY, WI 53128

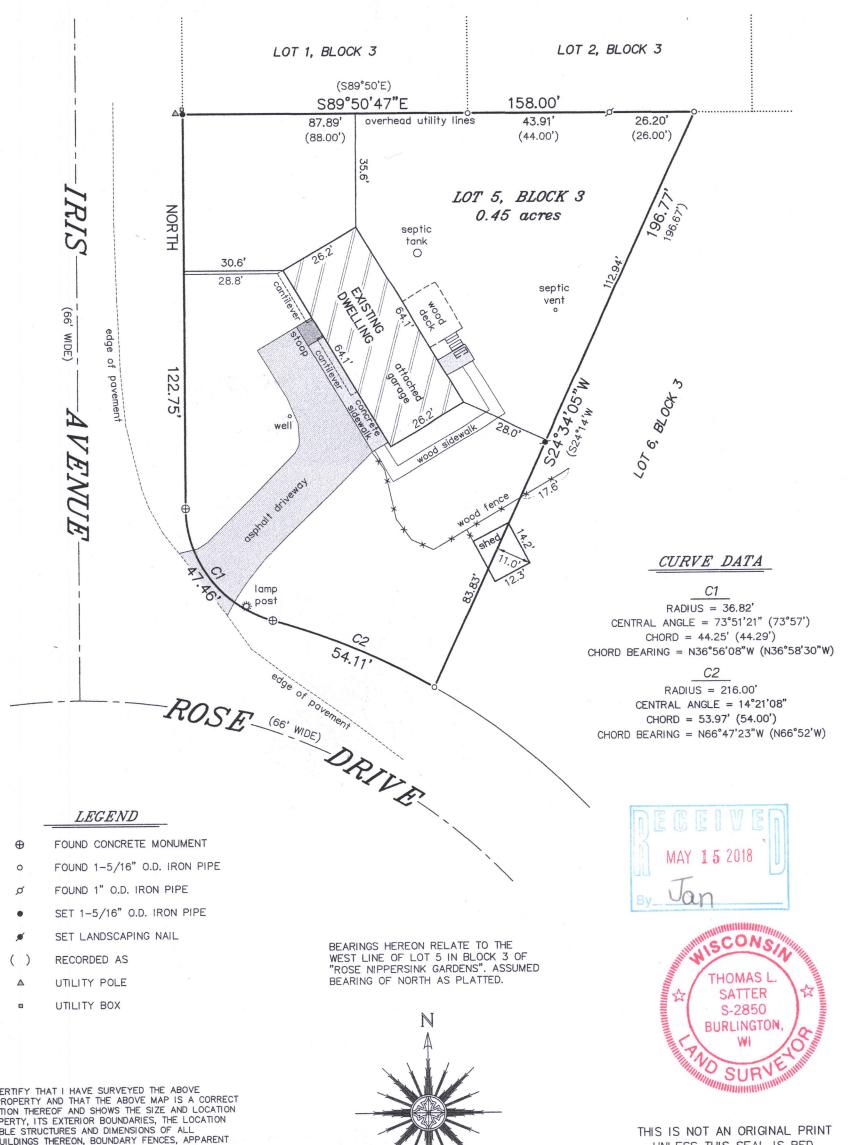


"I HEREBY CERTIFY THAT I HAVE SURVEYED THE ABOVE DESCRIBED PROPERTY AND THAT THE ABOVE MAP IS A CORRECT REPRESENTATION THEREOF AND SHOWS THE SIZE AND LOCATION OF THE PROPERTY, ITS EXTERIOR BOUNDARIES, THE LOCATION OF ALL VISIBLE STRUCTURES AND DIMENSIONS OF ALL PRINCIPAL BUILDINGS THEREON, BOUNDARY FENCES, APPARENT EASEMENTS, ROADWAYS AND ENCROACHMENTS, IF ANY."

"THIS SURVEY IS MADE FOR THE USE OF THE PRESENT OWNERS OF THE PROPERTY, AND THOSE WHO PURCHASE, MORTGAGE, OR GUARANTEE THE TITLE THERETO WITHIN ONE YEAR FROM DATE

## SATTER SURVEYING, LLC LAND SURVEYS, MAPPING AND PLANNING

272 ORIGEN STREET BURLINGTON, WI 53105 262-661-4239

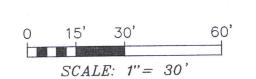

UNLESS THIS SEAL IS RED.

MARCH 20, 2018 DATE

021820 JOB NUMBER