

PLAT OF SURVEY OF


PHONE: 262-537-4874

FAX: 262-537-4221

EMAIL: ambit@tds.net

Lot 18 in TUSCANY SUBDIVISION, located in the Northwest Quarter of Section 3,
Town 1 North, Range 18 East of the 4th Principal Meridian Town of Bloomfield,
Walworth County, Wisconsin.

PARCEL IDENTIFICATION NO: MTU 00018

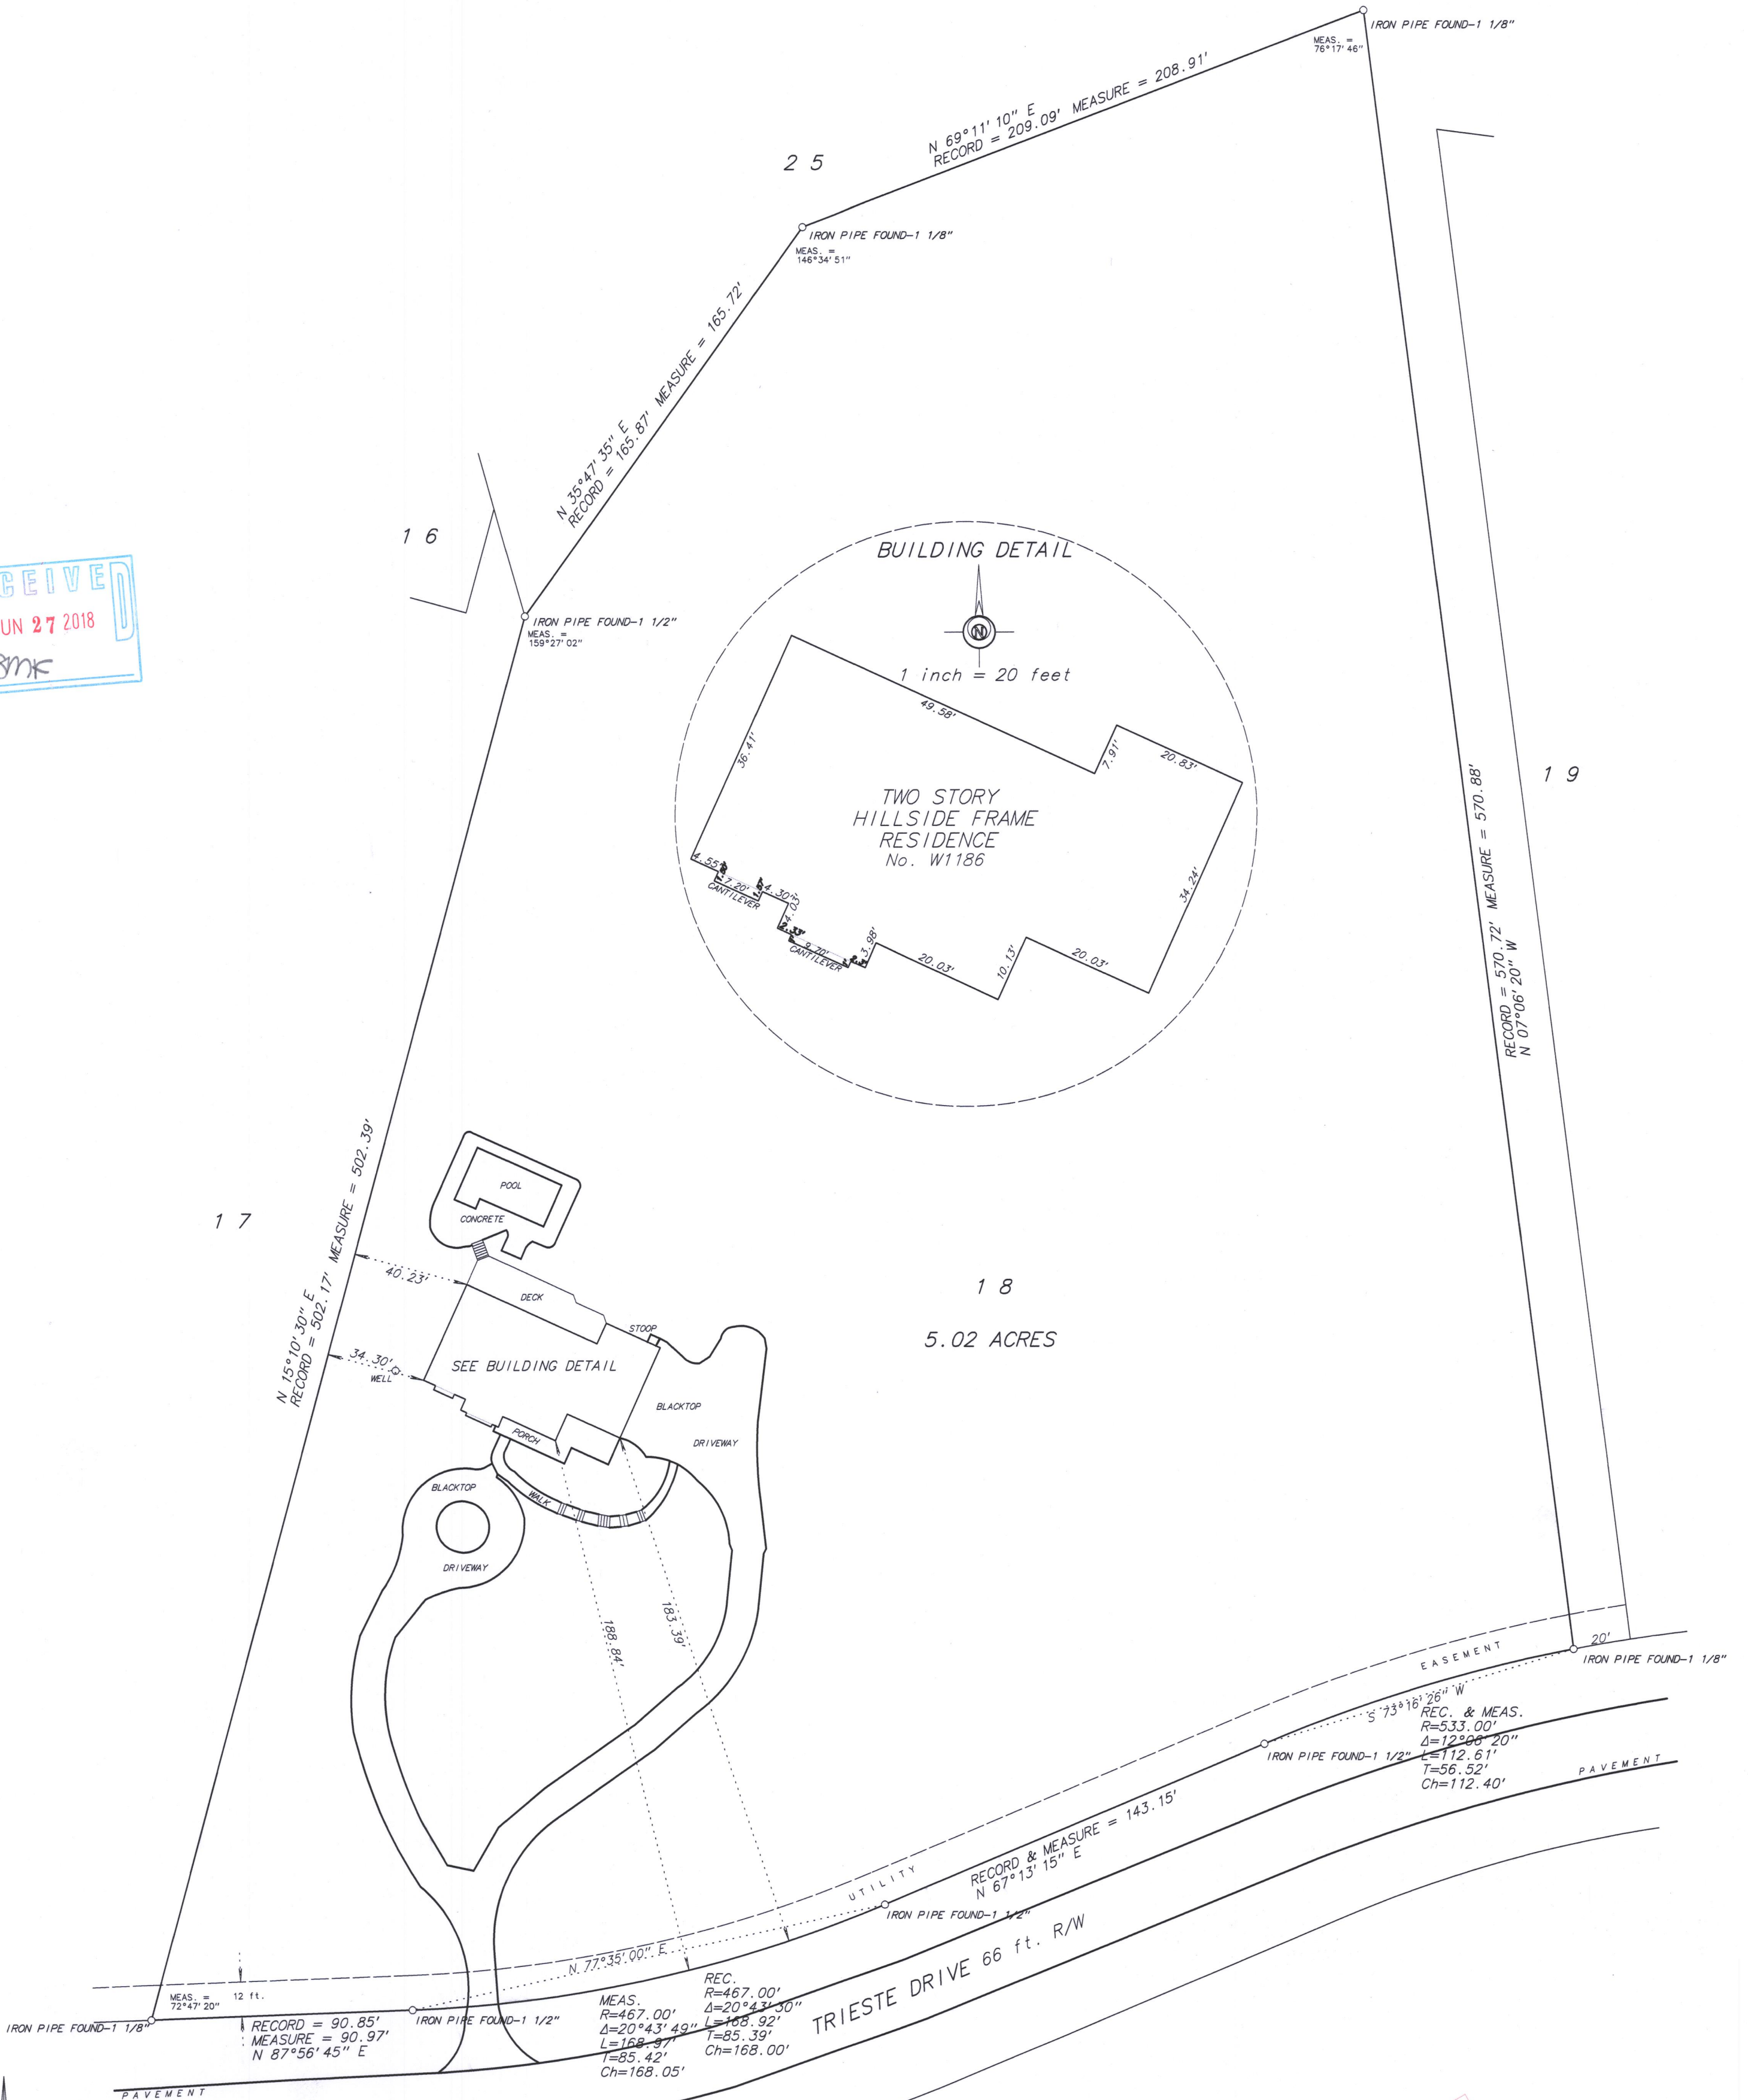

Fieldwork completed on and date of certification: March 22, 2017
I hereby certify that I have surveyed the above described property and the above
plot is a true representation thereof and shows the size and location of the
property, its exterior boundaries, the location and dimensions of all visible
structures thereon, boundary lines, apparent easements and roadways and visible
encroachments, if any.
This survey is made for the exclusive use of the present owners of the property,
and also those who purchase, mortgage or guarantee the title thereto within ONE
YEAR from the date hereof.
Dated at Cassett, Wisconsin this _____ day of _____ 2017.

Mark A. Bolender
Wisconsin Professional Land Surveyor - 1784

118-3371

SCALE: 1 inch = 40 feet
ORDERED BY: M. Larkin/KEEFE REAL ESTATE
JOB NO.: 17055

MTU-18