



BEARINGS HEREON RELATE TO THE NORTH LINE OF BLOCK 60 OF SECTION 2 OF PELL LAKE SUBDIVISION. ASSUMED BEARING OF SOUTH 87°30'00" WEST AS PLATTED.

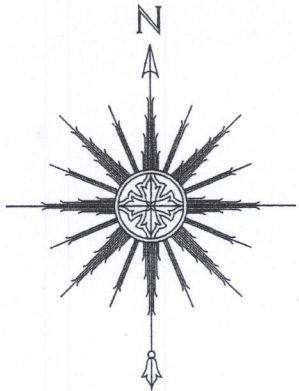

0 15' 30' 60'
SCALE: 1" = 30'

Old 1-3/4" outside diameter iron pipe

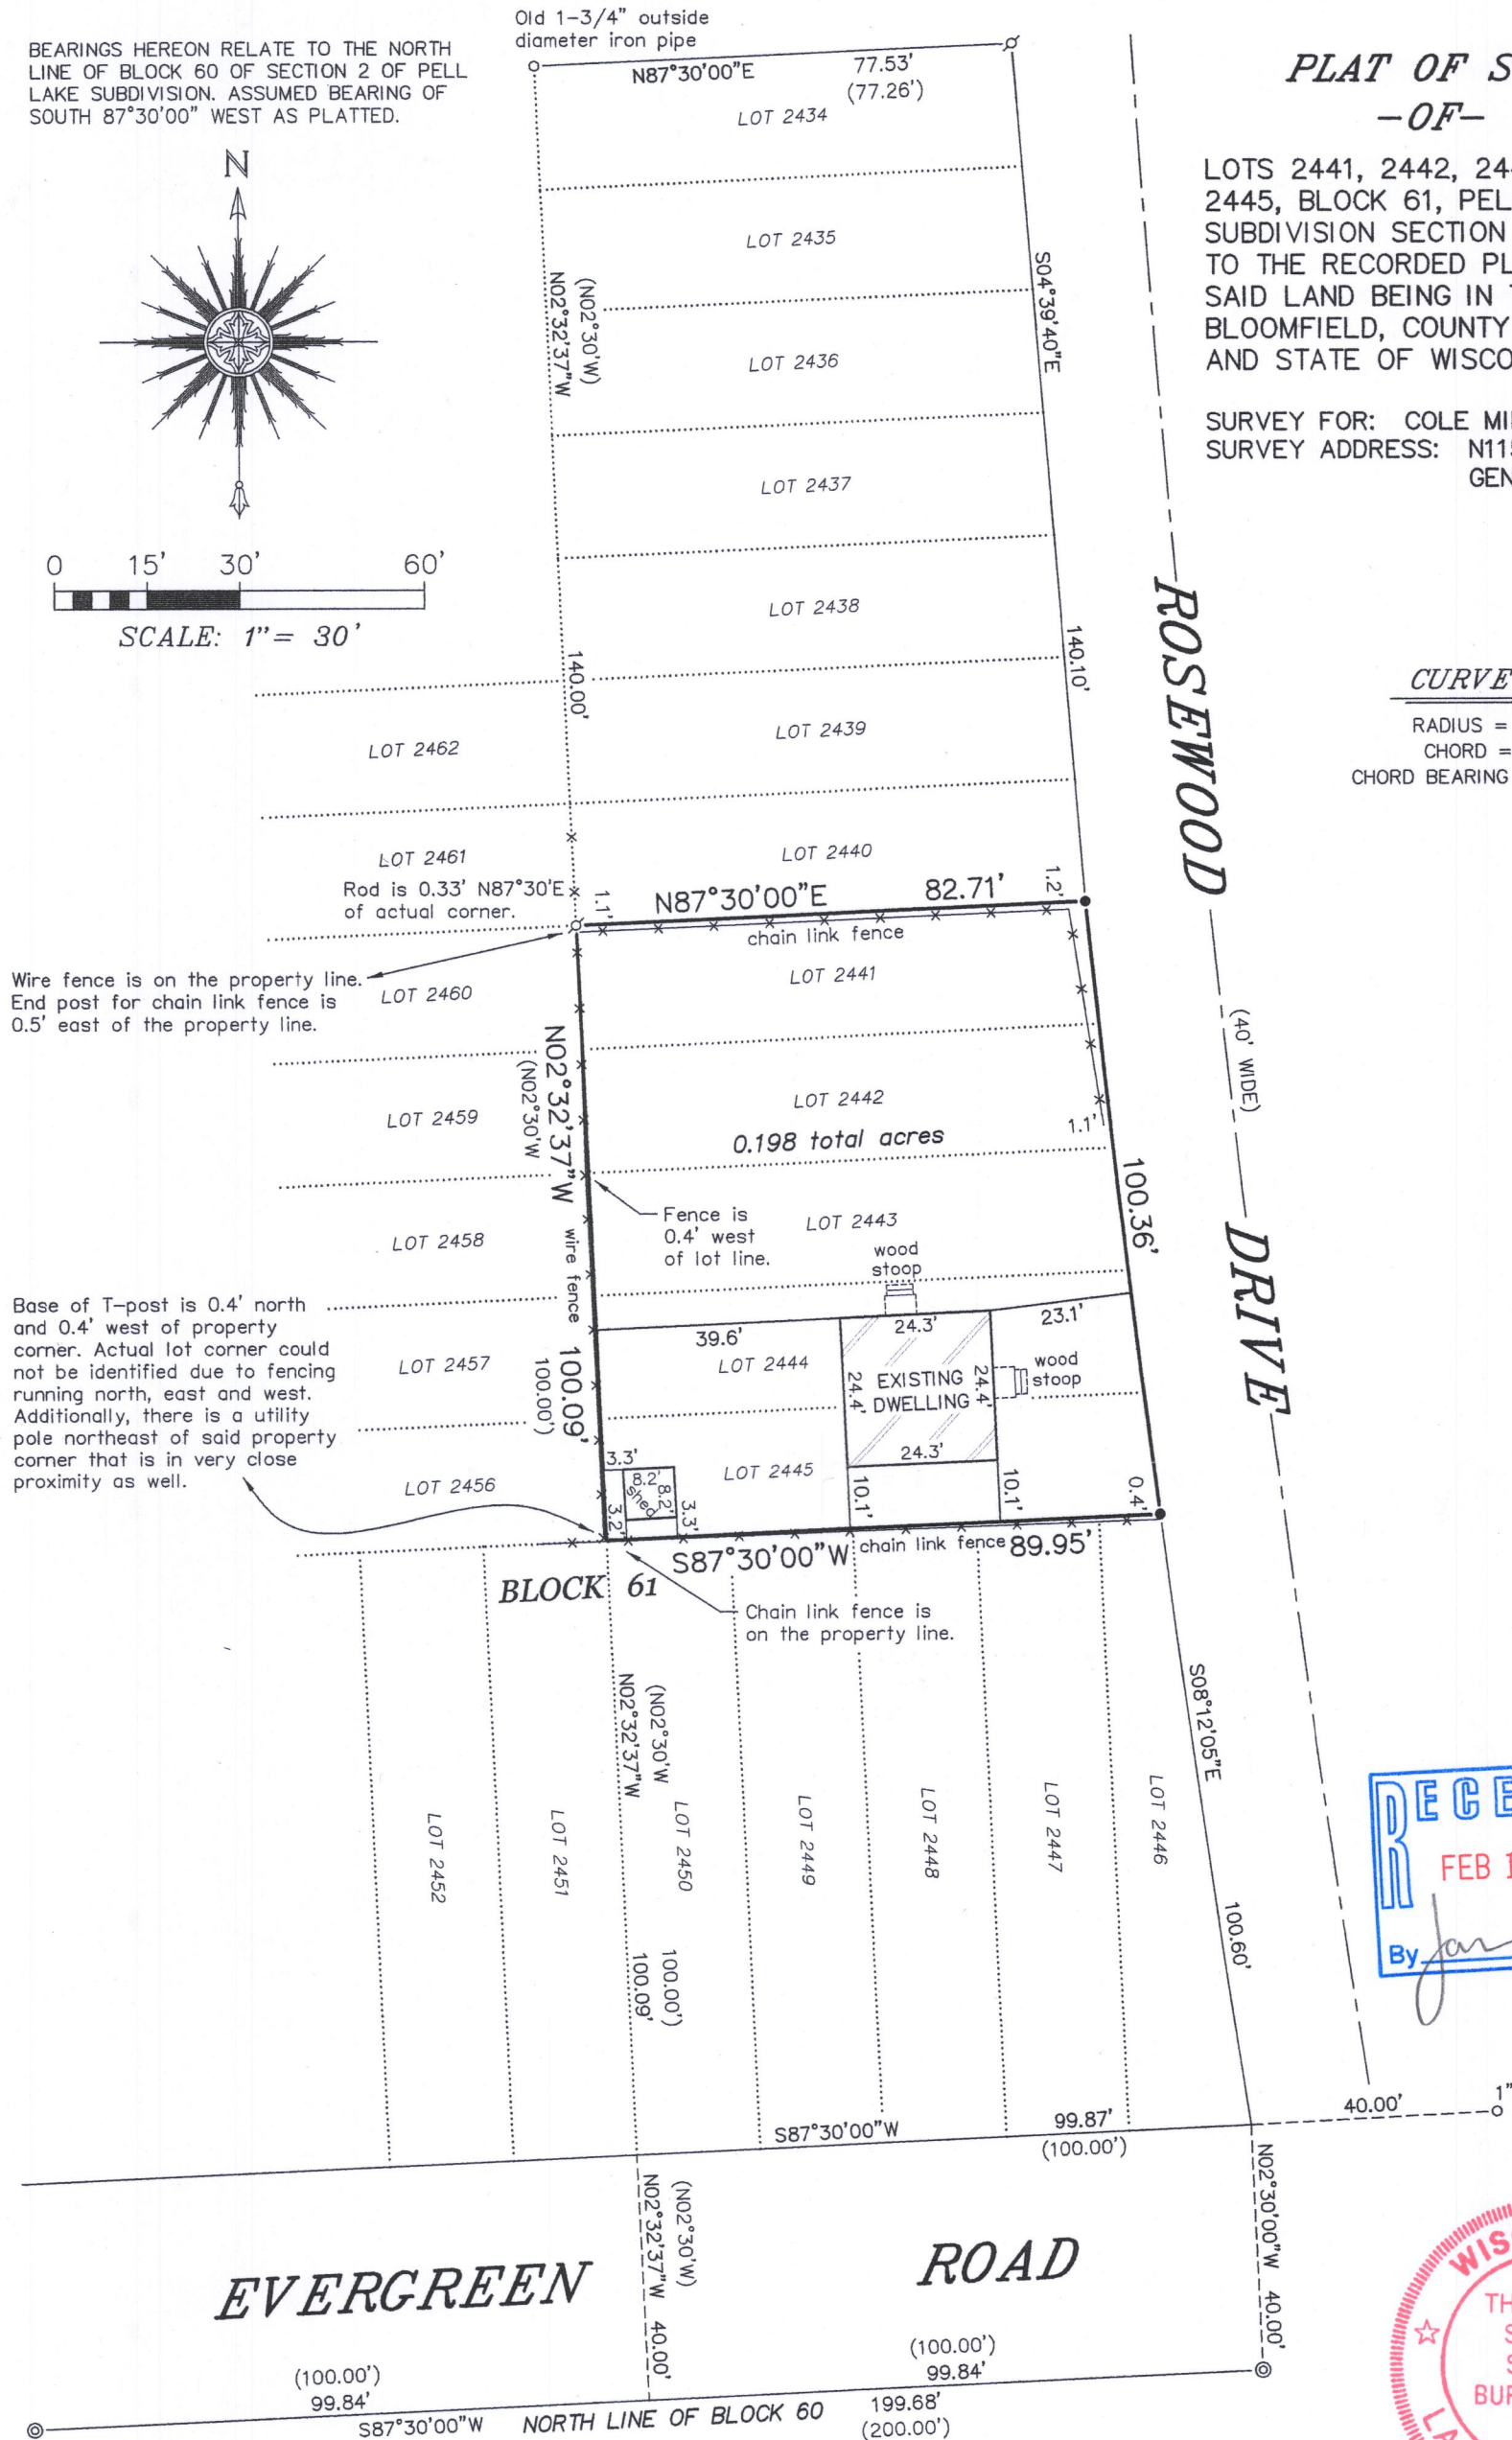


PLAT OF SURVEY -OF-

LOTS 2441, 2442, 2443, 2444, AND 2445, BLOCK 61, PELL LAKE SUBDIVISION SECTION 2, ACCORDING TO THE RECORDED PLAT THEREOF. SAID LAND BEING IN THE VILLAGE OF BLOOMFIELD, COUNTY OF WALWORTH AND STATE OF WISCONSIN.

SURVEY FOR: COLE MIKRUT
SURVEY ADDRESS: N1155 ROSEWOOD DR.
GENOA CITY, WI 53128

CURVE DATA

RADIUS = 3640.00'
CHORD = 100.36'
CHORD BEARING = S06°40'50"E

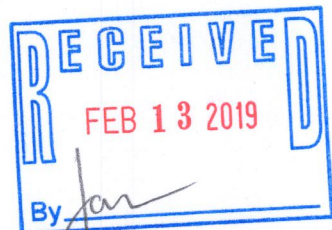

THIS IS NOT AN ORIGINAL PRINT
UNLESS THIS SEAL IS RED.

Thomas L. Satter

THOMAS L. SATTER

S-2850

"I HEREBY CERTIFY THAT I HAVE SURVEYED THE ABOVE DESCRIBED PROPERTY AND THAT THE ABOVE MAP IS A CORRECT REPRESENTATION THEREOF AND SHOWS THE SIZE AND LOCATION OF THE PROPERTY, ITS EXTERIOR BOUNDARIES, THE LOCATION OF ALL VISIBLE STRUCTURES AND DIMENSIONS OF ALL PRINCIPAL BUILDINGS THEREON, BOUNDARY FENCES, APPARENT EASEMENTS, ROADWAYS AND ENCROACHMENTS, IF ANY."

"THIS SURVEY IS MADE FOR THE USE OF THE PRESENT OWNERS OF THE PROPERTY, AND THOSE WHO PURCHASE, MORTGAGE, OR GUARANTEE THE TITLE THERETO WITHIN ONE YEAR FROM DATE HEREOF."

SATTER SURVEYING, LLC
LAND SURVEYS, MAPPING AND PLANNING
272 ORIGIN STREET
BURLINGTON, WI 53105
262-661-4239

LEGEND

- ⊙ FOUND 2-3/8" O.D. IRON PIPE
- FOUND IRON PIPE WITH OUTSIDE DIAMETER AS NOTED
- ⌘ FOUND 3/4" DIAMETER IRON ROD
- SET 1-5/16" O.D. IRON PIPE
- () RECORDED AS

DECEMBER 28, 2018
DATE

121801
JOB NUMBER

& PL-507

118-3419