


**PLAT OF SURVEY**  
-OF-

LOTS 905-908 IN BLOCK 19, 931 AND 932 IN BLOCK 19, EXCEPT THE EASTERLY 80 THEREOF, AND LOTS 937-942 IN BLOCK 19, ALL IN SECTION 1 OF PELL LAKE SUBDIVISION, LOCATED IN SECTIONS 15, 16, 21 AND 22, TOWN 1 NORTH, RANGE 18 EAST, IN THE VILLAGE OF BLOOMFIELD, WALWORTH COUNTY, WISCONSIN.

SURVEY FOR: DUSTIN GARROD  
SURVEY ADDRESS: N1240 PINE ROAD,  
GENOA CITY, WI 53128



NOTE: REFER TO A CURRENT TITLE REPORT FOR EASEMENTS, RESTRICTIONS OR COVENANTS WHICH MAY AFFECT THIS PROPERTY.

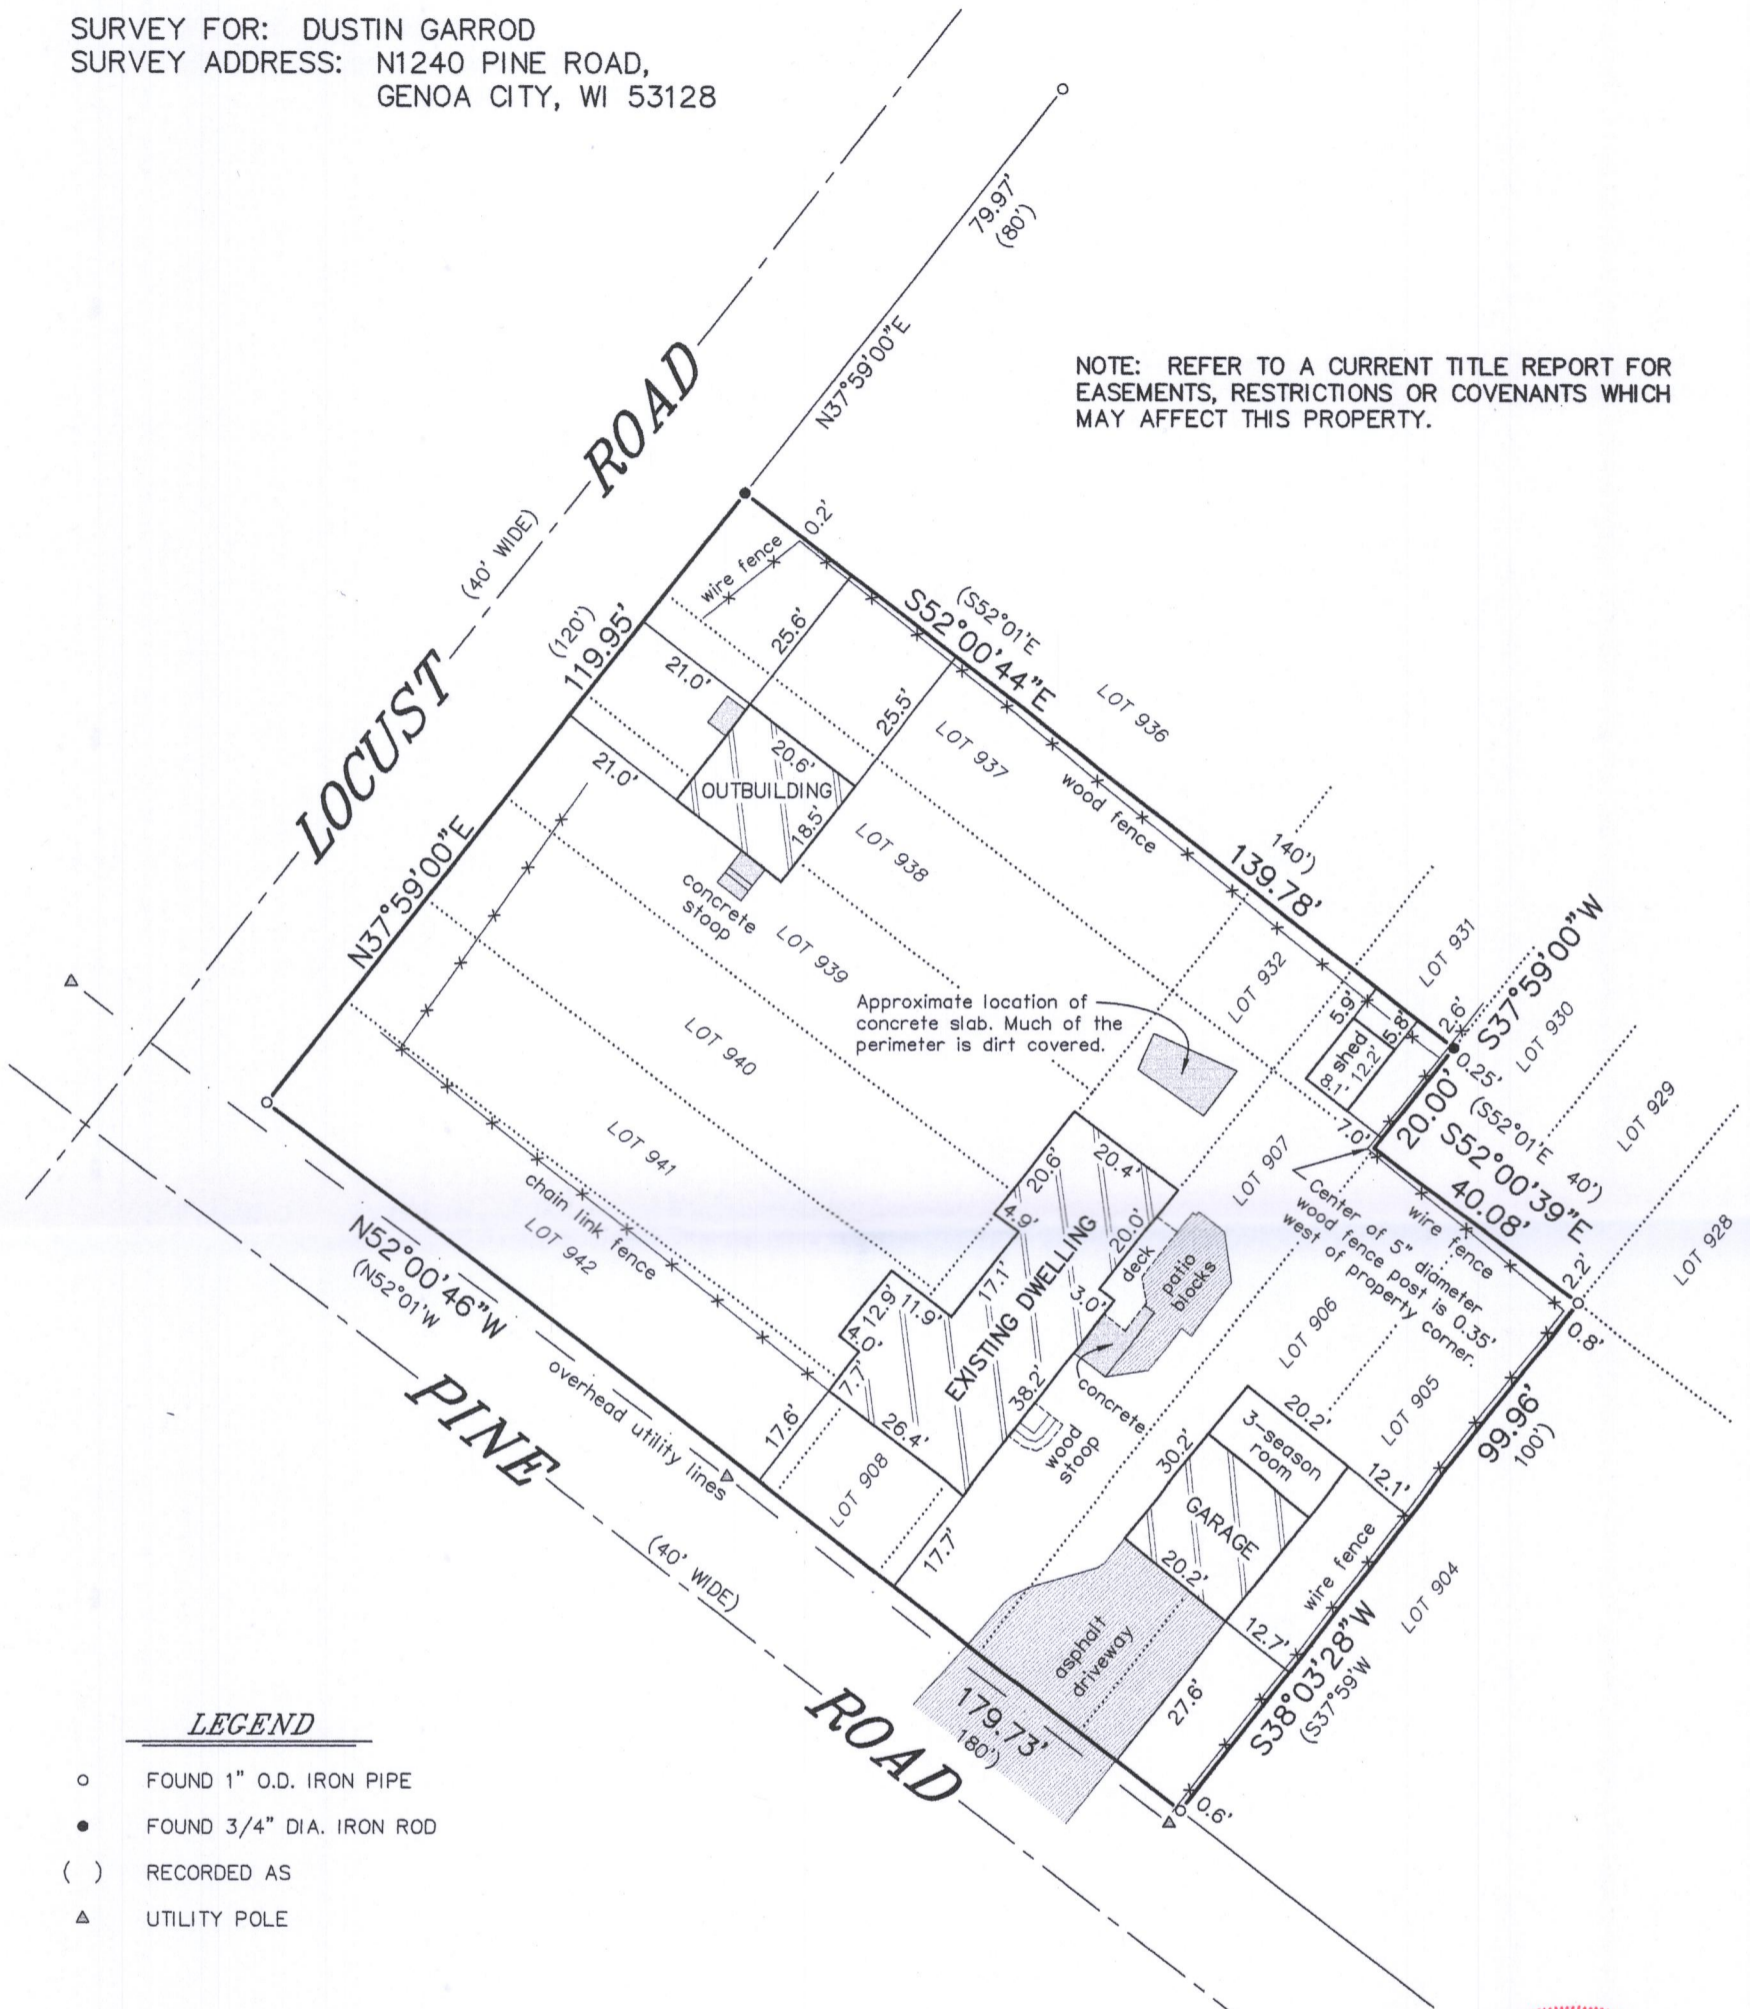

**LEGEND**



- FOUND 1" O.D. IRON PIPE
- FOUND 3/4" DIA. IRON ROD
- ( ) RECORDED AS
- ▲ UTILITY POLE

BEARINGS HEREON RELATE TO THE WESTERLY LINE OF BLOCK 19 OF SECTION 1 OF PELL LAKE SUBDIVISION. ASSUMED BEARING OF NORTH 37°59'00" EAST AS PLATTED.

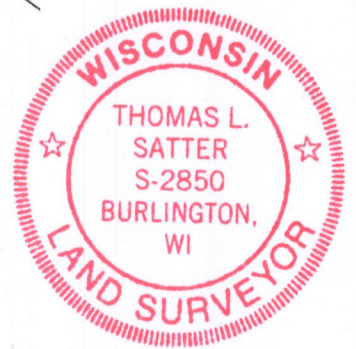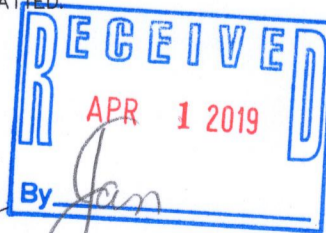

"I HEREBY CERTIFY THAT I HAVE SURVEYED THE ABOVE DESCRIBED PROPERTY AND THAT THE ABOVE MAP IS A CORRECT REPRESENTATION THEREOF AND SHOWS THE SIZE AND LOCATION OF THE PROPERTY, ITS EXTERIOR BOUNDARIES, THE LOCATION OF ALL VISIBLE STRUCTURES AND DIMENSIONS OF ALL PRINCIPAL BUILDINGS THEREON, BOUNDARY FENCES, APPARENT EASEMENTS, ROADWAYS AND ENCROACHMENTS, IF ANY."

"THIS SURVEY IS MADE FOR THE USE OF THE PRESENT OWNERS OF THE PROPERTY, AND THOSE WHO PURCHASE, MORTGAGE, OR GUARANTEE THE TITLE THERETO WITHIN ONE YEAR FROM DATE HEREOF."

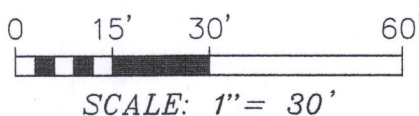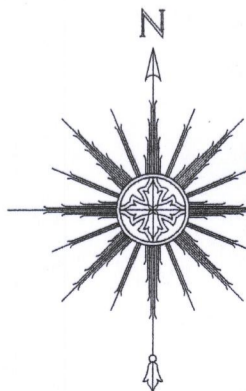

THIS IS NOT AN ORIGINAL PRINT UNLESS THIS SEAL IS RED.

*Thomas L. Satter*  
THOMAS L. SATTER S-2850

**SATTER SURVEYING, LLC**  
LAND SURVEYS, MAPPING AND PLANNING  
272 ORIGEN STREET  
BURLINGTON, WI 53105  
262-661-4239

MARCH 27, 2019  
DATE

031908  
JOB NUMBER

*dpl-201 118-3429*