


OF LOT 1 OF CERTIFIED SURVEY MAP No. 5083
BEING PART OF THE SW 1/4 OF THE NE 1/4 OF SECTION 12,
TOWNSHIP 1 NORTH, RANGE 18 EAST, OF THE 4TH P.M.,
TOWN OF BLOOMFIELD, WALWORTH COUNTY, WISCONSIN.

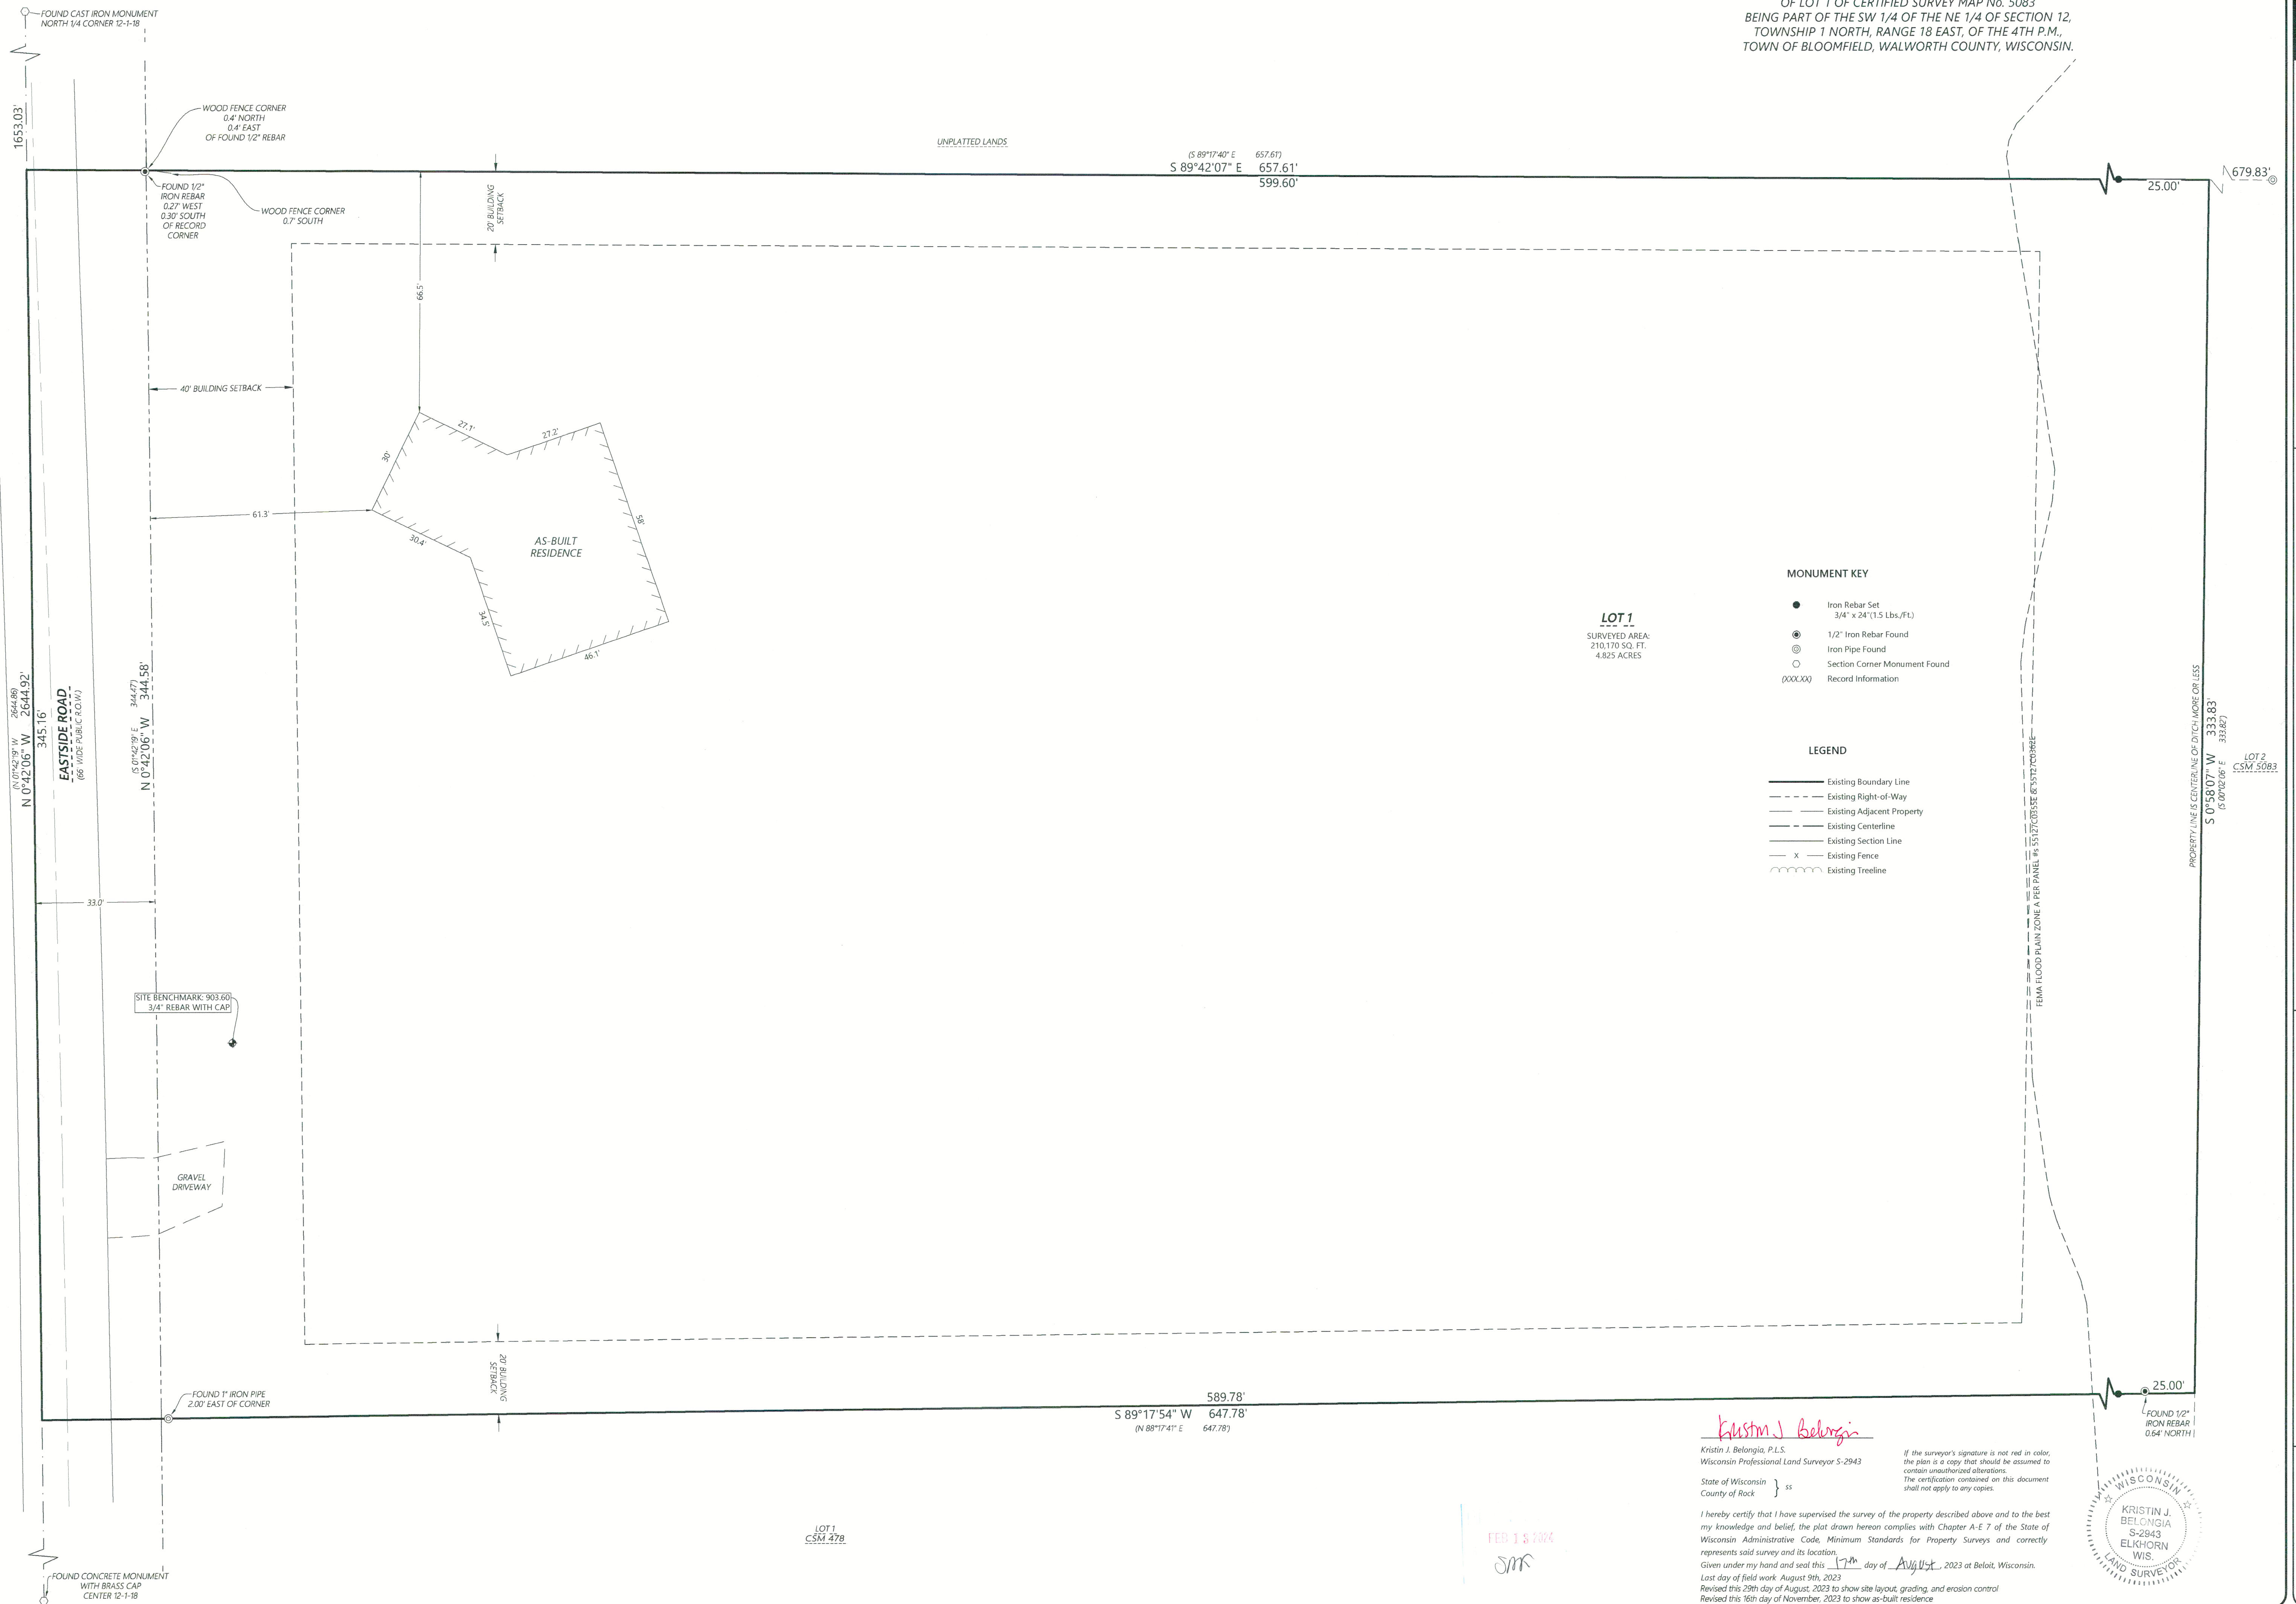

1040 N Wisconsin Street
Elkhorn, Wisconsin 53121
262.379.2250
www.rhbatterman.com

Batterman
engineers surveyors planners

PLAT OF SURVEY
FOR
CHRISTOPHER FREUND & JULIE BEATY
BLOOMFIELD, WISCONSIN

Christopher Freund & Julie B
635 Park Avenue
Twin Lakes, WI 53181

FIELD CREW: BMR / DM / DS
DRAWN BY: BMR
SHEET 1 OF 1

File Name: J:\34700-34799\34759 - Ingersoll - Freund-Booby\SURVEY\FHB DRAWING FILES