


BARBARA STOCHL  
PELL LAKE, WIS.

MAP NO.

SURVEY OF LOTS 1529-1530-1531-1539 & 1540 IN BLOCK 34 IN PELL  
LAKE SUBDIVISION IN SECTION 15 T.1N. R.10E. TOWNSHIP OF  
BLOOMFIELD, COUNTY OF WALWORTH, STATE OF WISCONSIN.

I HEREBY CERTIFY THAT I HAVE SURVEYED THE LAND DESCRIBED  
ABOVE AND THAT THE MAP DRAWN HEREON IS CORRECT TO THE BEST OF  
MY KNOWLEDGE AND BELIEF OCT. 16 1973.

*Carl Degen*  
SURVEYOR #200 W.R.L.S.

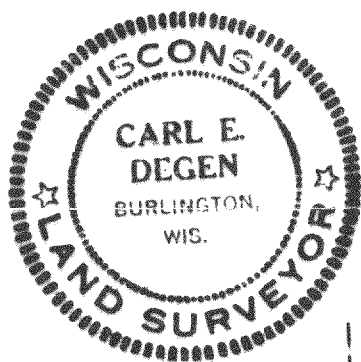

LEGEND  
O = IRON STAKE SET  
⊙ = IRON STAKE FOUND  
⊠ = DRY WELL  
SCALE 1" = 30'  
DATE 10-16-1973

