
## HAROLD H. KOLB

REGISTERED PROFESSIONAL LAND SURVEYOR

LAKE GENEVA, WISCONSIN

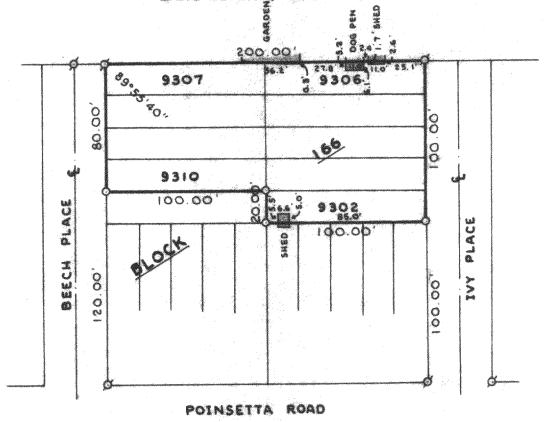

PLAT OF SURVEY OF

Lots 9302-9310, Block 166, Section

5 of Pell Lake Subdivision, T 1 N,

R 18 E, Walworth County, Wisconsin.





SCALE: 1": 60"

## LEGEND

- φ IRON PIPE FOUND
- O IRON PIPE PLACED
- . CONCRETE MONUMENT
- X SPIKE



I. HAROLD H. KOLB, DO HEREBY CERTIFY THAT I HAVE SURVEYED THE PROPERTY HEREON DESCRIBED ACCORDING TO THE OFFICIAL RECORDS, AND THAT THE PLAT HEREON IS A CORRECT REPRESENTATION OF THE LOT LINES.

Marved N. Son

HAROLD H. KOLB WISCONSIN REGISTERED LAND SURVEYOR, S-187

DATE June 1, 1974

118-440