


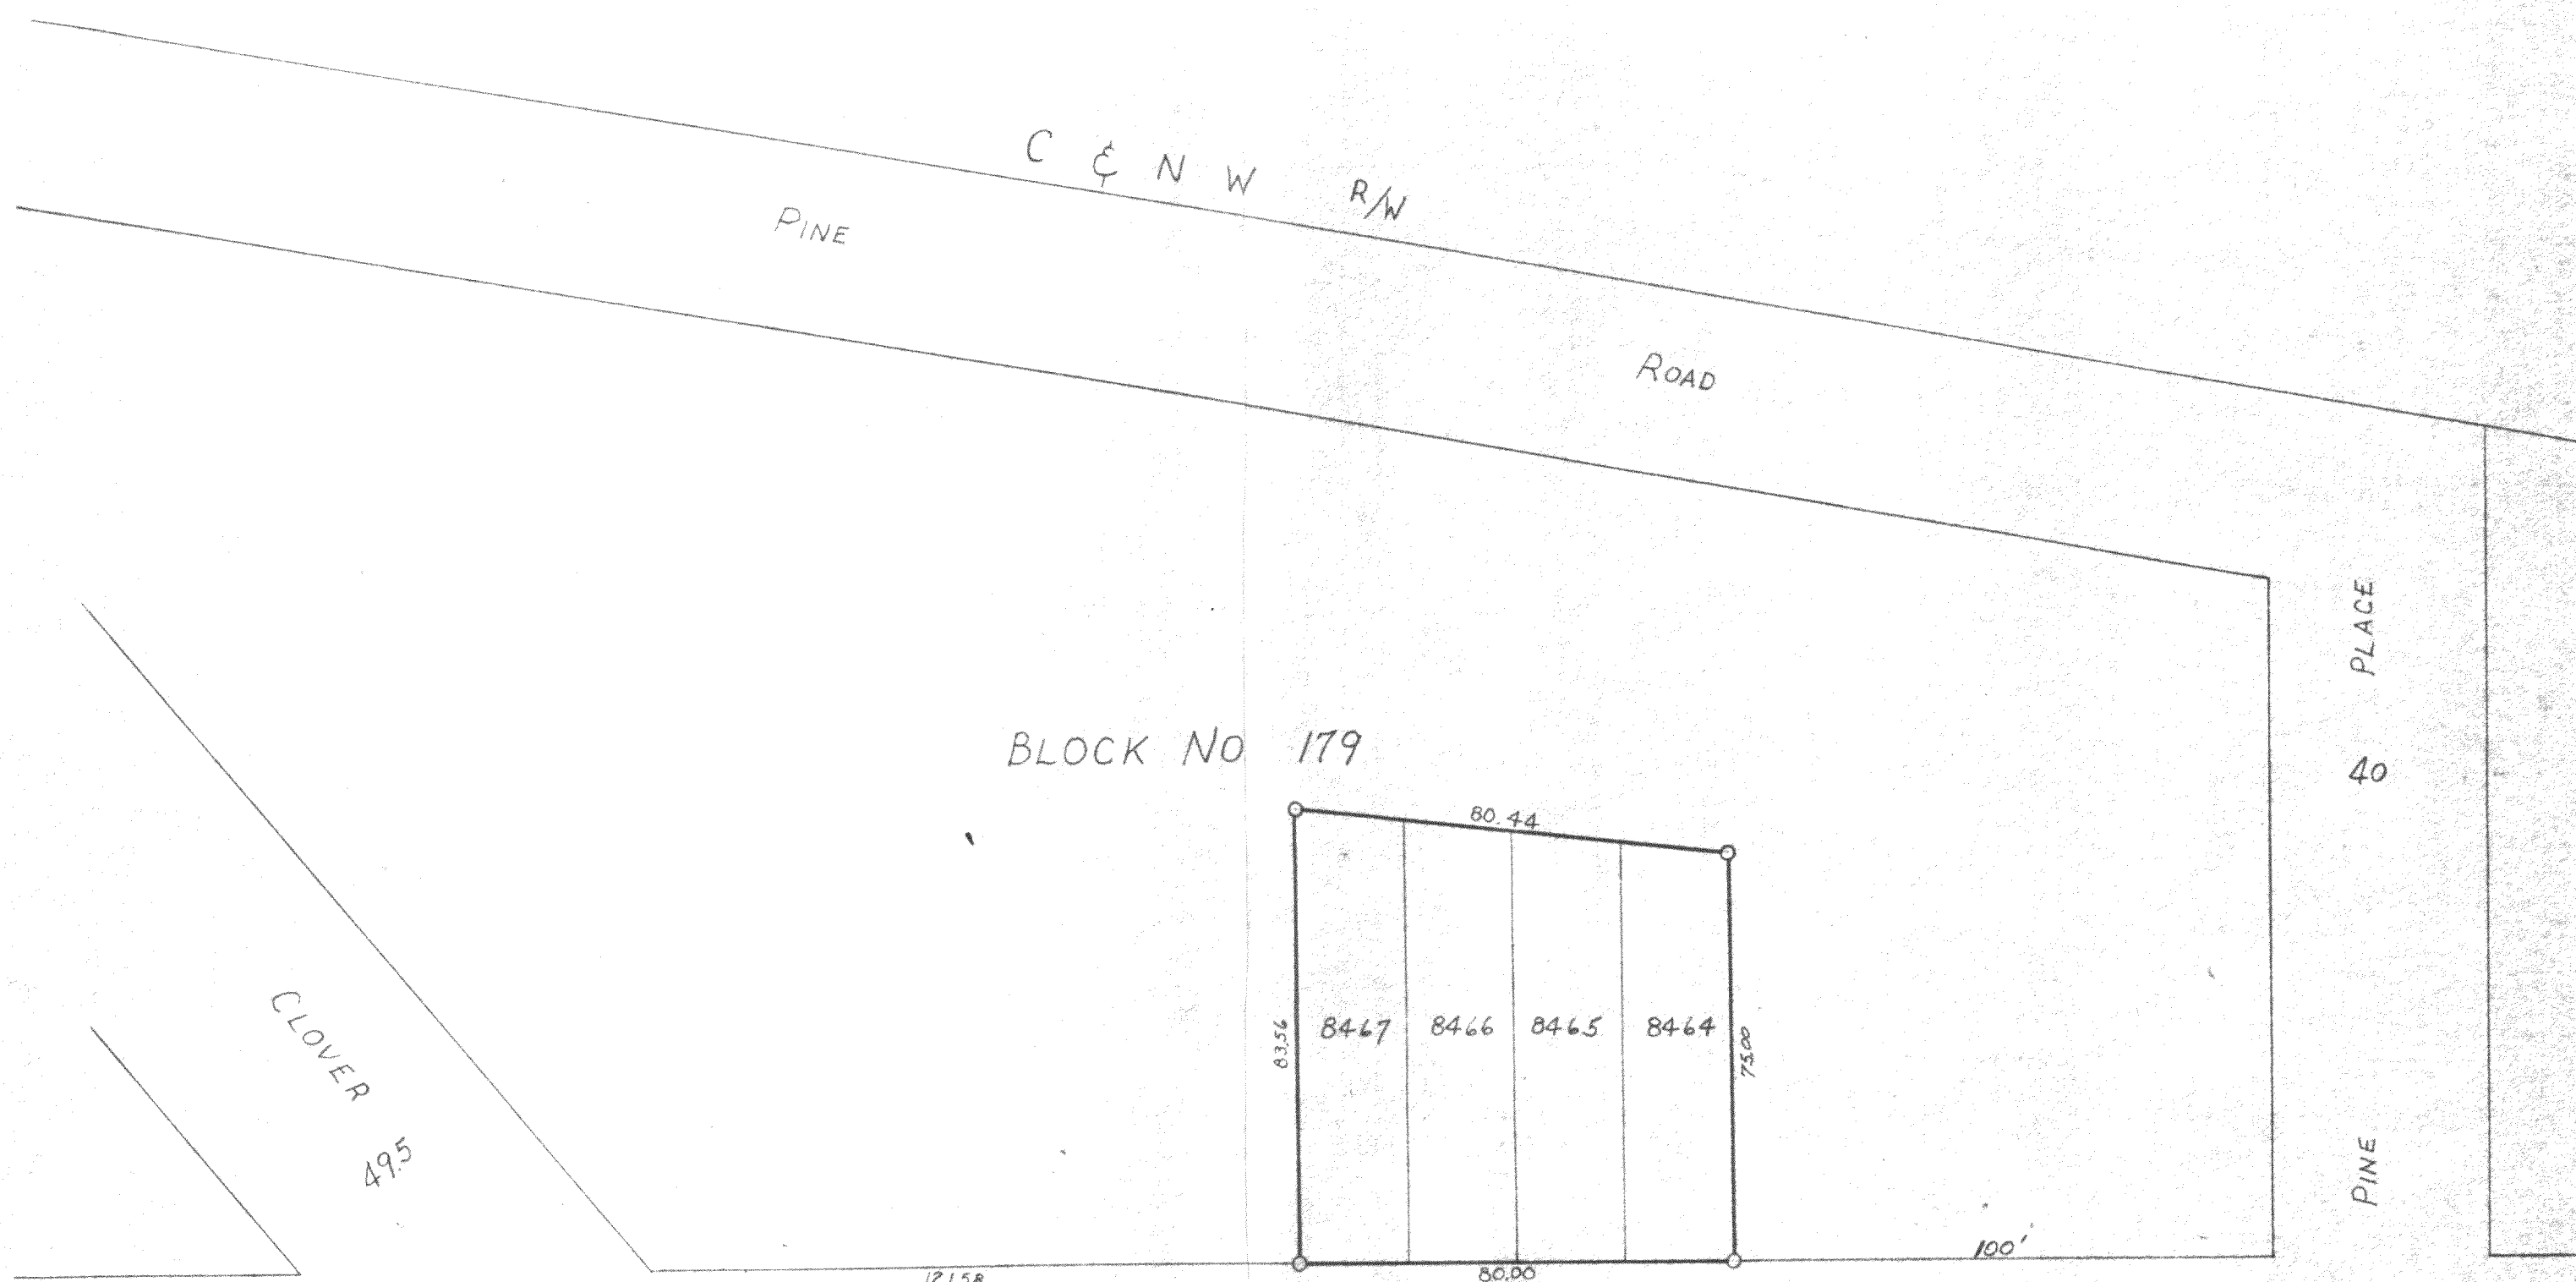

○ - INDICATES IRON PIPE

118-46

PLAT OF SURVEY
OF
LOT NOS. 8464 - 8467 (INCL)
OF BLOCK No. 179
SECTION 5 OF PELL LAKE
WALNORTH COUNTY, WISCONSIN

Lloyd P. Jensen
SURVEYOR

SCALE 1" = 30'

DATE APRIL 17, 1953