


# HAROLD H. KOLB

REGISTERED PROFESSIONAL LAND SURVEYOR  
LAKE GENEVA, WISCONSIN

HILLSIDE BOULEVARD · 50' WIDE

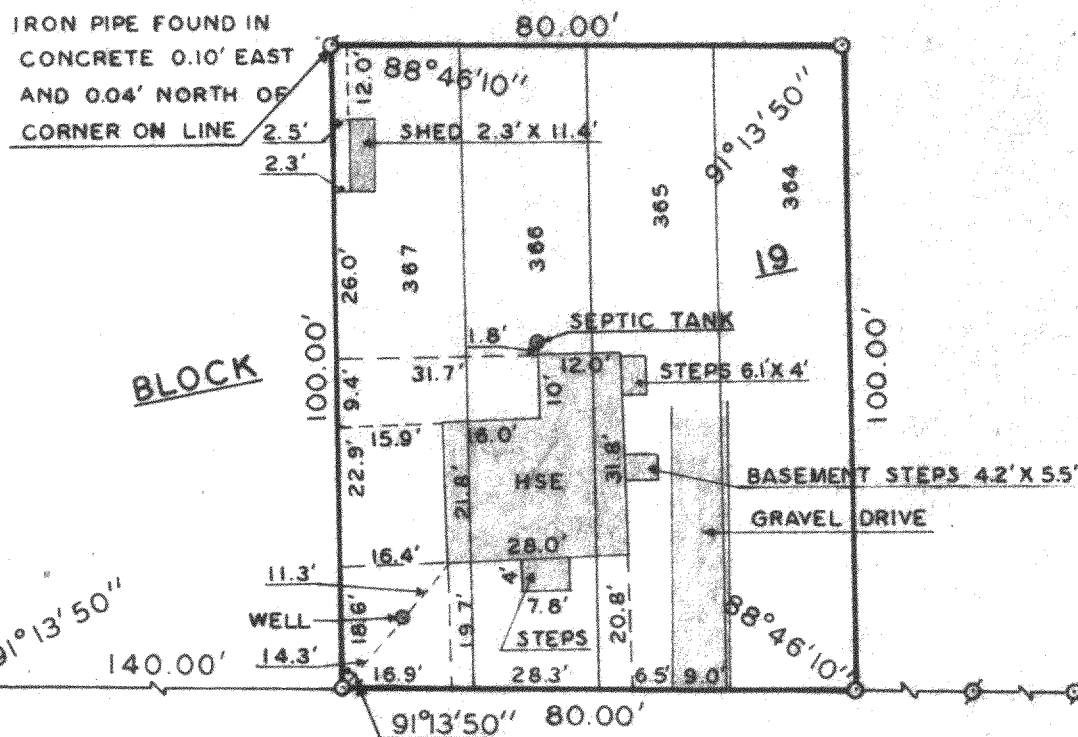

GREENVIEW ROAD · 40' WIDE

## PLAT OF SURVEY OF

Lots 364-367, Block 19, Pell Lake  
Highlands Subdivision, T1N, R18E,  
Walworth County, Wisconsin.

OWNER: Rose Burns

ACCURACY: Distances  $\pm 0.01'$   
Angles  $\pm 05''$   
Error of closure  
less than 1/3000


N



SCALE · 1" = 30'

## LEGEND

- φ — IRON PIPE FOUND
- — IRON PIPE PLACED
- — CONCRETE MONUMENT
- x — SPIKE

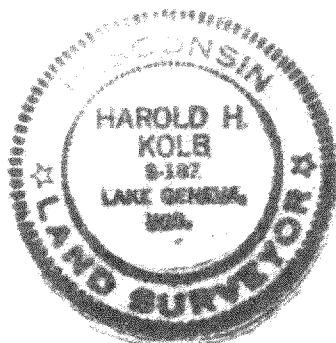

I, HAROLD H. KOLB, DO HEREBY CERTIFY THAT I HAVE  
SURVEYED THE PROPERTY HEREON DESCRIBED ACCORDING  
TO THE OFFICIAL RECORDS, AND THAT THE PLAT HEREON  
IS A CORRECT REPRESENTATION OF THE LOT LINES.

*Harold H. Kolb*

HAROLD H. KOLB  
WISCONSIN REGISTERED LAND SURVEYOR, S-187

DATE Sept 4, 1974

118-463