
HAROLD H. KOLB

REGISTERED PROFESSIONAL LAND SURVEYOR LAKE GENEVA, WISCONSIN

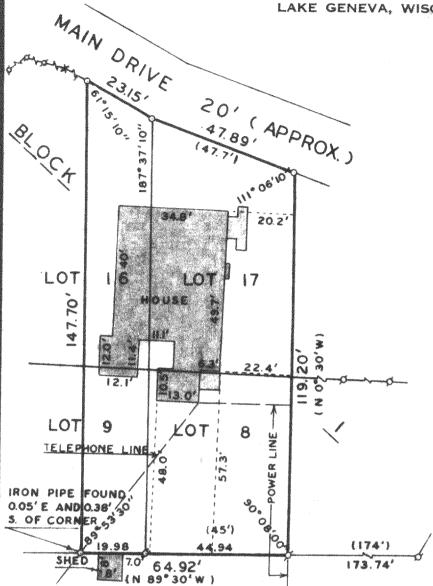

PLAT OF SURVEY OF

THE EAST 1/2 OF LOTS 9 AND 16 AND LOTS 8 AND 17, BLOCK 1, SHINNER'S 3RD ADDITION TO NIPPERSINK PARK, SECTION 24, T1N, R18E, WALWORTH COUNTY, WISCONSIN.

ACCURACY: DISTANCE ± 0.01'
ANGLES ± 05''
ERROR OF CLOUSRE
LESS THAN 1/3000

OWNER: LOUIS LEVIN

I hereby certify that I have surveyed the above described property and that the above map is a true representation thereof and shows the size and location of the property, its exterior boundaries, the location of all visible structures and dimensions of all principal buildings thereon, boundary

fences, apparent easements and roadways and visible encroachments, if any.

This survey is made for the use of the present owners of the property, and also those who purchase, mortgage, or guarantee the title within one (1) year from date hereof.

SCALE: 1"= 30"

φ - IRON PIPE FOUND

O - IRON PIPE PLACED

- CONCRETE MONUMENT

X - SPIKE

()- AS PLATTED



I. HAROLD H. KOLB, DO HEREBY CERTIFY THAT I HAVE SURVEYED THE PROPERTY HEREON DESCRIBED ACCORDING TO THE OFFICIAL RECORDS, AND THAT THE PLAT HEREON IS A CORRECT REPRESENTATION OF THE LOT LINES.

Horabl 3. Roll

HAROLD H. KOLB
WISCONSIN REGISTERED LAND SURVEYOR, S-187
DATE Sent 22 /475

REVISED: SEPTEMBER 26, 1975
REVISED: OCTOBER 14, 1975

118-502